


STATE OF KANSAS  
STATE CORPORATION COMMISSION

Give All Information Completely  
Make Required Affidavit

Mail or Deliver Report to:  
Conservation Division  
State Corporation Commission  
211 S. Broadway  
Wichita, Kansas

WELL PLUGGING RECORD

NORTH

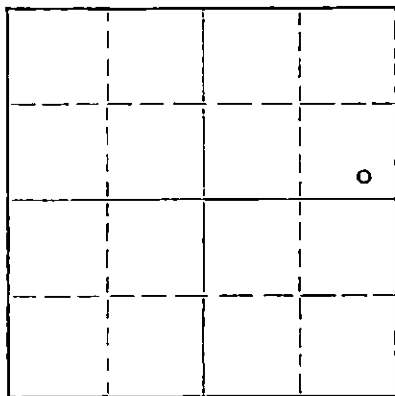

Locate well correctly on above  
Section Plat

Pawnee County. Sec. 15 Twp. 21 Rge. (E) 16(W)  
Location as "NE/CNW%SW%" or footage from lines SE SE NE  
Lease Owner Murfin & Aurora  
Lease Name Glaze Well No. 1  
Office Address Union Nat. Bank Bldg - Wichita, Ks.  
Character of Well (completed as Oil, Gas or Dry Hole) dry hole  
Date well completed 3-16-1956  
Application for plugging filed 3-16-1956  
Application for plugging approved 3-16-1956  
Plugging commenced 3-16-1956  
Plugging completed 3-16-1956  
Reason for abandonment of well or producing formation dry

If a producing well is abandoned, date of last production 19  
Was permission obtained from the Conservation Division or its agents before plugging was commenced? yes

Name of Conservation Agent who supervised plugging of this well Mr. Brundage, Hoisington, Ks.  
Producing formation Depth to top Bottom Total Depth of Well 3910 Feet  
Show depth and thickness of all water, oil and gas formations.

OIL, GAS OR WATER RECORDS

CASING RECORD

FORMATION	CONTENT	FROM	TO	SIZE	PUT IN	PULLED OUT
				8 5/8	990'	none

Describe in detail the manner in which the well was plugged, indicating where the mud fluid was placed and the method or methods used in introducing it into the hole. If cement or other plugs were used, state the character of same and depth placed, from feet to feet for each plug set.

Filled hole with mud laden fluid.  
Set bottom plug at 300' with 25 sacks cement.  
Set 2nd plug at 35' with 10 sacks cement.

(If additional description is necessary, use BACK of this sheet)

Name of Plugging Contractor Murfin Drilling Co.  
Address 507 Union Nat. Bank Bldg - Wichita, Ks.

STATE OF Kansas COUNTY OF Sedgwick ss.  
W. R. Murfin (employee of owner) or (owner or operator) of the above-described well, being first duly sworn on oath, says: That I have knowledge of the facts, statements, and matters herein contained and the log of the above-described well as filed and that the same are true and correct. So help me God.

(Signature) *WR Murfin*  
(Address)

SUBSCRIBED AND SWORN to before me this 2nd day of April, 1956.

My commission expires 6-13-59.

*Betty Spriggs* Notary Public.

PLUGGING  
FILE SEC 15 T 21 R 16W  
BOOK PAGE 46 LINE 22

APR 19 1956  
CONSERVATION DIVISION  
Wichita, Kansas

4-5-56

WELL LOG

15.145.00125.0000

COMPANY Murfin & Aurora

SEC. 15 T. 21 R. 16W

FARM GLAZE NO. 1

LOC. SE SE NE

TOTAL DEPTH 3910

COUNTY Pawnee  
KANSAS


COMM. 3-3-56

COMP. 3-16-56

SHOT OR TREATED

CONTRACTOR Murfin Drilling Co.

ISSUED

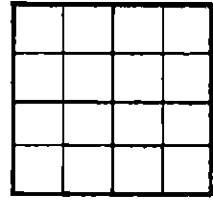

CASING

20 10  
15 8 990' with 500 sx.  
12 6  
13 5

ELEVATION 1980 DF

PRODUCTION D & A

FIGURES INDICATE BOTTOM OF FORMATIONS

Tops:

180	Sand - Red Bed		
940	Red Bed	Anhydrite	986
986	Red Rock - Shale	Heebner	3374
990	Anhydrite	Brown lime	3468
1390	Red Bed - Shale	Lansing	3477
1800	Shale	Base Kansas City	3712
1905	Shale - Lime Streaks	Viola	3746
2085	Lime	Simpson	3821
3155	Lime - Shale	Arbuckle	3882
3275	Lime	TD	3910
3329	Lime - Shale		
3375	Lime		
3480	Shale - Lime		
3727	Lime		
3823	Lime - Cherty Shale		
3864	Sandy Shale		
3886	Shale - Sand - Lime		
3910	Shale - Lime		

**PLUGGING**  
FILE SEC. 15 T. 21 R. 16W  
BOOK PAGE 46 LINE 22

NOTARY PUBLIC  
WICHITA, KANSAS

State of Kansas }  
County of Sedgwick } ss:

I, W. R. Murfin of the Murfin Drilling Company

upon oath state that the above and foregoing is a true and correct copy of the log of the Glaze #1 well.

WR Murfin

Subscribed and sworn to before me this 2nd day of April 1956.

My Commission Expires: 6-13-59.

Betty Spraggi  
NOTARY PUBLIC