


WELL PLUGGING RECORD

Give All Information Completely  
Make Required Affidavit  
Mail or Deliver Report to:  
Conservation Division  
State Corporation Commission  
211 No. Broadway  
Wichita, Kansas

NORTH

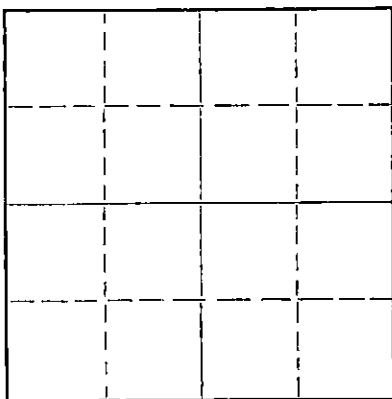

Locate well correctly on above  
Section Plat

~~XXX~~ Pawnee County. Sec. 36 Twp. 21 Rge. (E) 15 (W)  
Location as "NE/CNW/SW" or footage from lines NE NE SW  
Lease Owner Thunderbird Drilling, Inc.  
Lease Name Yeager Well No. 1  
Office Address 712 Union Center, Wichita 2, Kansas  
Character of Well (completed as Oil, Gas or Dry Hole) Dry Hole  
Date well completed December 11 19 58  
Application for plugging filed December 11 19 58  
Application for plugging approved December 11 19 58  
Plugging commenced December 11 19 58  
Plugging completed December 11, 19 58  
Reason for abandonment of well or producing formation Dry Hole

If a producing well is abandoned, date of last production \_\_\_\_\_ 19\_\_\_\_  
Was permission obtained from the Conservation Division or its agents before plugging was commenced? Yes

Name of Conservation Agent who supervised plugging of this well Mr. Frank Broadfoot, St. John, Kansas  
Producing formation \_\_\_\_\_ Depth to top \_\_\_\_\_ Bottom \_\_\_\_\_ Total Depth of Well 3760 Feet  
Show depth and thickness of all water, oil and gas formations.

OIL, GAS OR WATER RECORDS

CASING RECORD

FORMATION	CONTENT	FROM	TO	SIZE	PUT IN	PULLED OUT
		0	268	8 5/8"	279.33'	None

Describe in detail the manner in which the well was plugged, indicating where the mud fluid was placed and the method or methods used in introducing it into the hole. If cement or other plugs were used, state the character of same and depth placed, from \_\_\_\_\_ feet to \_\_\_\_\_ feet for each plug set.

Hole filled with heavy mud to 240'. Bottom plug set at 240' with 1/4 sack of Hulls & 20 sacks of cement, mixed and poured through drill pipe. Hole filled to 35'. Top plug set at 35' with 1/4 sack of Hulls and 10 sacks of cement.

RECEIVED  
STATE CORPORATION COMMISSION

DEC 17 1958

CONSERVATION DIVISION  
Wichita, Kansas

(If additional description is necessary, use BACK of this sheet)  
Name of Plugging Contractor Thunderbird Drilling, Inc.  
Address 712 Union Center, Wichita, Kansas

STATE OF KANSAS COUNTY OF SEDGWICK, ss.  
Charles W. Aikins, Jr. (owner or operator) of the above-described well, being first duly sworn on oath, says: That I have knowledge of the facts, statements, and matters herein contained and the log of the above-described well as filed and that the same are true and correct. So help me God.  
(Signature) [Signature]  
712 Union Center, Wichita, Kansas  
(Address)

SUBSCRIBED AND SWORN TO before me this 16th day of December, 19 58

My commission expires Sept. 5, 1960 Jenell Schartz Notary Public.

PLUGGING  
FILE SEC. 36 T. 21 R. 15W  
BOOK PAGE 4 LINE 39

## THUNDERBIRD DRILLING, INC.

## WELL LOG

## #1 YEAGER

LOCATION: NE NE SW, Sec. 36,  
Twp. 21.S, Rge. 15.W,  
Pawnee County, Kansas

CONTRACTOR: Thunderbird Drilling, Inc.  
712 Union Center  
Wichita, Kansas

SURFACE CASING: 8 5/8" set at 268' with 190 sacks  
of cement, 2% gel and 4 sacks  
of Calcium Chloride.

OIL STRING: None

ELEVATION: 1965' K. B.  
1962' D. F.  
1959' G. L.

COMMENCED: December 1, 1958

COMPLETED: December 11, 1958

## WELL LOG

0 - 100	Surface Clay & Sand
100 - 155	Sand
155 - 340	Shale
340 - 470	Dakota Sand
470 - 909	Red Bed
909 - 935	Anhydrite
935 - 1720	Shale & Shells
1720 - 2050	Shale & Lime
2050 - 2305	Lime
2305 - 2975	Shale & Lime
2975 - 3295	Lime
3295 - 3340	Shale & Lime
3340 - 3365	Lime
3365 - 3440	Shale & Lime
3440 - 3680	Lime
3680 - 3740	Shale & Lime
3740 - 3760	Lime & Chert
3760	Rotary Total Depth

The undersigned, Charles W. Aikins, Jr., an officer of Thunderbird Drilling, Inc., hereby certifies that the above is a true and correct log of the formations encountered in the drilling of the #1 Yeager as shown in the daily drilling reports.

THUNDERBIRD DRILLING, INC.

Charles W. Aikins, Jr., Pres.

**RECEIVED**  
STATE CORPORATION COMMISSION

DEC 17 1958

CONSERVATION DIVISION  
Wichita, Kansas

Subscribed and sworn to before me this 16th day of December, 1958

Jenell Schartz - Notary Public

My commission expires:  
September 5, 1960.

**PLUGGING**  
FILE SEC. 36 T. 21 R. 15W  
BOOK PAGE 4 LINE 39