


STATE OF KANSAS
STATE CORPORATION COMMISSION

WELL PLUGGING RECORD

Give All Information Completely
Make Required Affidavit
Mail or Deliver Report to:
Conservation Division
State Corporation Commission
211 No. Broadway
Wichita, Kansas

Pawnee County, Sec. 36 Twp. 21 Rge. (E) 15(W)
Location as "NE/CNW%SW%" or footage from lines C NW SE

Lease Owner Woodman & Iannitti Drilling Company
Lease Name MacDonnell Well No. 1
Office Address 706 Union National Building
Character of Well (completed as Oil, Gas or Dry Hole) Dry
Date well completed Feb. 21 19 66
Application for plugging filed Feb. 21 19 66
Application for plugging approved Feb. 21 19 66
Plugging commenced Feb. 21 19 66
Plugging completed Feb. 21 19 66
Reason for abandonment of well or producing formation Dry

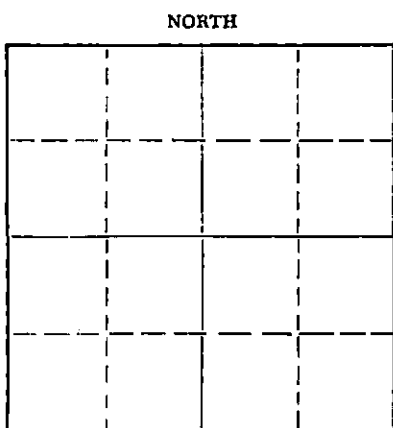

Locate well correctly on above
Section Plat

If a producing well is abandoned, date of last production 19
Was permission obtained from the Conservation Division or its agents before plugging was commenced? Yes

Name of Conservation Agent who supervised plugging of this well Gilbert Lieker
Producing formation Depth to top Bottom Total Depth of Well 3620 Feet
Show depth and thickness of all water, oil and gas formations.

OIL, GAS OR WATER RECORDS

CASING RECORD

FORMATION	CONTENT	FROM	TO	SIZE	PUT IN	PULLED OUT
				8 5/8	275'	

Describe in detail the manner in which the well was plugged, indicating where the mud fluid was placed and the method or methods used in introducing it into the hole. If cement or other plugs were used, state the character of same and depth placed, from feet to feet for each plug set.

Bottom plug @ 400' w/25 sx
Top plug @ 260' w/20 sx

RECEIVED
STATE CORPORATION COMMISSION

MAR 7 1966

CONSERVATION DIVISION
Wichita, Kansas

(If additional description is necessary, use BACK of this sheet)
Name of Plugging Contractor Woodman & Iannitti Drilling Company
Address 706 Union National Building

STATE OF Kansas, COUNTY OF Sedgwick, ss.
K. T. Woodman (employee of owner) or (owner or operator) of the above-described

well, being first duly sworn on oath, says: That I have knowledge of the facts, statements, and matters herein contained and the log of the above-described well as filed and that the same are true and correct. So help me God.

(Signature) K. T. Woodman
706 Union National Bldg.
(Address)

SUBSCRIBED AND SWORN to before me this 28th day of February, 1966

My commission expires Feb. 11, 1968

Justina Chamberlain
Justina Chamberlain Notary Public.

15.145.30098.0006


KANSAS GEOLOGICAL SOCIETY
KANSAS WELL LOG BUREAU - KANSAS WELL SAMPLE BUREAU
KANSAS GEOLOGICAL SOCIETY BUILDING
508 EAST MURDOCK - WICHITA, KANSAS

COMPANY Woodman & Iannitti Drilling Co.
FARM MacDonnell NO. 1

SEC. 36 T. 21 R. 15W
LOC. C NW SE

TOTAL DEPTH 3620'
COMM. February 14, 1966 COMP. February 21, 1966
SHOT OR TREATED
CONTRACTOR Woodman & Iannitti Drilling Co.
ISSUED

COUNTY Pawnee

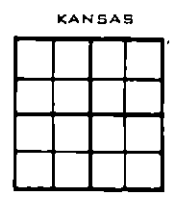

CASING
20 10
15 8 5/8 @ 275' w/225 SX
12 6
13 5

ELEVATION 1964 KB

PRODUCTION D & A

FIGURES INDICATE BOTTOM OF FORMATIONS

- 150 Sand
- 190 Sand
- 215 Hard Sand
- 240 Sand & Shale
- 275 Shale
- 370 Shale
- 500 Sand
- 890 Red Bed
- 908 Red Bed
- 935 Anhy
- 1200 Shale & Salt
- 1485 Shale & Shells
- 1755 Shale & Shells
- 1815 Lime & Shale
- 1960 Lime
- 2075 Lime
- 2205 Lime & Shale
- 2410 Lime & Shale
- 2560 Lime
- 2725 Lime & Shale
- 2820 Lime
- 2945 Lime
- 3035 Lime
- 3105 Lime
- 3190 Lime
- 3260 Lime
- 3310 Lime
- 3425 Lime
- 3505 Lime
- 3568 Lime
- 3620 Lime
- 3620 Total Depth

RECEIVED
STATE CORPORATION COMMISSION
MAR 1 1966
CONSERVATION DIVISION
Wichita, Kansas

I certify the above to be a true and correct copy of the driller's copy and the geological tops to the best of knowledge and belief.

K. T. Woodman
K. T. Woodman