

STATE OF KANSAS  
STATE CORPORATION COMMISSION

WELL PLUGGING RECORD

Give All Information Completely  
Make Required Affidavit  
Mail or Deliver Report to:  
Conservation Division  
State Corporation Commission  
800 Biting Building  
Wichita, Kansas


OR

FORMATION PLUGGING RECORD

Strike out upper line  
when reporting plugging  
of formations.

Rice County. Sec. 4 Twp. 21S Rge. 6W (E) (W)  
Location as "NE $\frac{1}{4}$ NW $\frac{1}{4}$ SW $\frac{1}{4}$ " or footage from lines. NWC SW  
Lease Owner Branine-Holl  
Lease Name Fee Well No. 4  
Office Address 705 Fourth National Bank Bldg., Wichita, Kansas  
Character of Well (completed as Oil, Gas or Dry Hole) Dry Hole  
Date well completed December 23, 19 47  
Application for plugging filed April 29, 19 48  
Application for plugging approved April 29, 19 48  
Plugging commenced April 30, 19 48  
Plugging completed May 5, 19 48  
Reason for abandonment of well or producing formation Dry Hole

NORTH

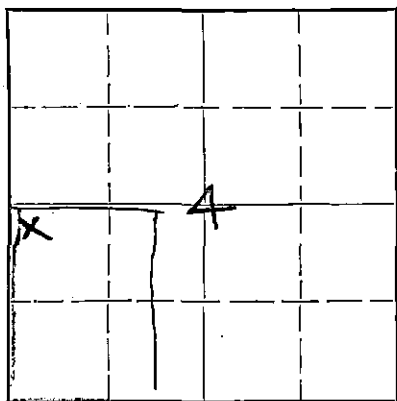

Locate well correctly on above  
Section Plat

If a producing well is abandoned, date of last production 19  
Was permission obtained from the Conservation Division or its agents before plugging was commenced? Yes

Name of Conservation Agent who supervised plugging of this well C. D. Stough  
Producing formation Depth to top Bottom Total Depth of Well 3508 Feet  
Show depth and thickness of all water, oil and gas formations.

OIL, GAS OR WATER RECORDS

CASING RECORD

Formation	Content	From	To	Size	Put In	Pulled Out

Describe in detail the manner in which the well was plugged, indicating where the mud fluid was placed and the method or methods used in introducing it into the hole. If cement or other plugs were used, state the character of same and depth placed, from feet to feet for each plug set.

8 5/8" at 264 feet. Circulated with cement. 5 1/2" at 3436. Perforated from 3446 to 3463 feet. Lead wool and Lane Wells plugs 3508 feet to 3470 feet. Mud from 3470 feet to 3430 feet. 5 Sax cement dumped at 3430 feet. Heavy mud to 264 feet. Wood plug, bridge and 15 sax cement at 264 feet. Heavy mud to 25 feet. Wood plug and 10 sax cement to surface.

JUN 21 1948

(If additional description is necessary, use BACK of this sheet)

Correspondence regarding this well should be addressed to Branine-Holl  
Address 705 Fourth National Bank Bldg.,  
Wichita, Kansas

STATE OF \_\_\_\_\_, COUNTY OF \_\_\_\_\_, SS.

(employee of owner) or (owner or operator) of the above-described well, being first duly sworn on oath, says: That I have knowledge of the facts, statements, and matters herein contained and the log of the above-described well as filed and that the same are true and correct. So help me God.

(Signature) X *J. J. Holl* X

(Address)

SUBSCRIBED AND SWORN to before me this *Twenty First* day of *June*, 19 *48*

My commission expires *11-5-51*

PLUGGING  
FILE SEC 4 T21 R6W  
BOOK PAGE 26 LINE 14

22-2625 2-48-15M

*J. P. Roberts*  
Notary Public.

WELL LOG ON THE FEE #4

Spudding date: 12/14/47  
 Date casing set: 12/23/47  
 Date rotary completed: 12/23/47  
 Date cable completed:

Location:  
 Section 4, Twp. 21S, Rge. 6W,  
 TOTAL DEPTH 3443' Rice County, Kansas

FROM	TO	FORMATION	REMARKS
0	85	Sand	
85	195	Sand and shale	
195	264	Red bed	Ran 12 Jts. 8-5/8 casing.
264	1050	Shale and shells	Set at 264' with
1050	1580	Shale and lime	
1580	1720	Shale and shells	
1720	1750	Lime and shale	
1750	2240	shale and shells	
2240	2430	Shale and lime	
2430	3340	Lime	
3340	3443	Shale	Ran 110 Jts. 5-1/2" casing.
3443	TOTAL DEPTH		Set at 3443'

Subscribed and sworn to before me this  
 22nd day of January, 1948.

I certify the above and foregoing to be  
 a true and exact copy of the original  
 driller's log on the Fee #4 well.

Almeda Johnson  
 Notary Public.

G. L. Kalling

My commission expires: My commission expires March 22, 1952

