

STATE OF KANSAS  
STATE CORPORATION COMMISSION

Form CP-4

WELL PLUGGING RECORD

Give All Information Completely  
Make Required Affidavit  
Mail or Deliver Report to:  
Conservation Division  
State Corporation Commission  
271 No. Broadway  
Wichita, Kansas

Rice County. Sec. 4 Twp. 21 Rge. 6 (E) W (W)

Location as "NE/CNW\*SW\*" or footage from lines. NE NW NW

Lease Owner Sterling Drilling Company

Lease Name ~~Cleavinger~~ Cleavinger Well No. 5

Office Address Sterling, Kansas

Character of Well (completed as Oil, Gas or Dry Hole) \_\_\_\_\_

Date well completed \_\_\_\_\_ 19\_\_

Application for plugging filed \_\_\_\_\_ 19\_\_

Application for plugging approved \_\_\_\_\_ 19\_\_


Plugging commenced 6-14-66 \_\_\_\_\_ 19\_\_

Plugging completed 6-16-66 \_\_\_\_\_ 19\_\_

Reason for abandonment of well or producing formation Depleted.

If a producing well is abandoned, date of last production \_\_\_\_\_ 19\_\_

Was permission obtained from the Conservation Division or its agents before plugging was commenced? yes

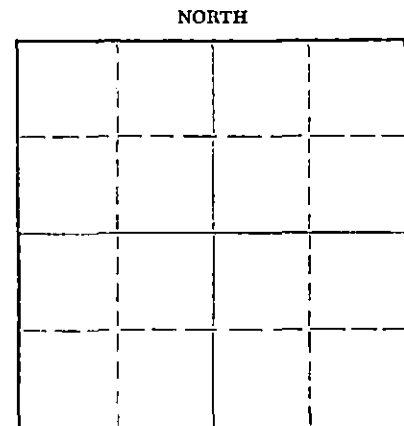

Locate well correctly on above Section Plat

Name of Conservation Agent who supervised plugging of this well Gilbert Toman

Producing formation \_\_\_\_\_ Depth to top \_\_\_\_\_ Bottom \_\_\_\_\_ Total Depth of Well 3430 Feet

Show depth and thickness of all water, oil and gas formations.

OIL, GAS OR WATER RECORDS

CASING RECORD

FORMATION	CONTENT	FROM	TO	SIZE	PUT IN	PULLED OUT
				8-5/8"	189'	None
				5-1/2"	3416'	2749'

Describe in detail the manner in which the well was plugged, indicating where the mud fluid was placed and the method or methods used in introducing it into the hole. If cement or other plugs were used, state the character of same and depth placed, from \_\_\_\_\_ feet to \_\_\_\_\_ feet for each plug set.

Checked hole to 3430', sanded hole to 3400' and dumped 5 sacks of cement @ 3400' with dump bailer. Pulled 5 1/2" casing, set rock bridge from 190' to 180' and dumped 20 sacks of cement @ 180'. Mudded hole to 30' and ran 10 sacks of cement to base of cellar.

RECEIVED  
STATE CORPORATION COMMISSION  
JUL 5 1966  
CONSERVATION DIVISION  
Wichita, Kansas

PLUGGING COMPLETE.

(If additional description is necessary, use BACK of this sheet)  
Name of Plugging Contractor KNIGHT CASING PULLING COMPANY  
Address CHASE, KANSAS

STATE OF KANSAS, COUNTY OF RICE, ss.  
Noel J. Knight (employee of owner) or (~~owner or operator~~) of the above-described well, being first duly sworn on oath, says: That I have knowledge of the facts, statements, and matters herein contained and the log of the above-described well as filed and that the same are true and correct. So help me God.

(Signature) Noel J. Knight  
Chase, Kansas  
(Address)

SUBSCRIBED AND SWORN TO before me this 29th day of June, 1966

My commission expires May 20, 1968 Milton J. Volin Notary Public.

## GROUP EXPLORATION CO.

BOX 218  
STERLING, KANSAS

WELL LOG ----- CLEVINGER #5

Location - NE/4 NW/4 NW/4 of Section 4-218-67, Rice County, Kansas

Owner - Seeger Oil & Gas Company  
Rotary Drilling Contractor - Group Exploration Company  
Cable Tools Contractor - Sterling Drilling CompanyCommenced - 4-9-52  
Completed - 4-19-52 (w/r)  
              - 4-23-52 (w/c.t.)Total Depth - 3417' (w/r)  
              - 3428' (w/c.t.)ELEVATION: 1628 DF  
              1625 GrLOG

0- 125	Shale and Sand
125-190	Shale and Shells
190- 800	Shale
800-1840	Shale and Lime
1840-2160	Shale and Shells
2160-2420	Shale and Lime
2420-2575	Lime
2575-2600	Shale
2600-2660	Lime
2660-2800	Shale
2800-2855	Shale and Lime
2855-3380	Lime
3380-3413	Shale and Lime
3413-3417	Lime - Mississippi
3417-3418	Shale and Chat
3418-3423	Soft Chat, Mulsified Oil & Gas
3423-3428	Very soft Chat

CASING RECORD

195' of 8-5/8" Surface Pipe  
Cemented 1' off bottom with 100 Sacks

3422' of 5 1/2" O. D. Casing  
set 1' off bottom  
Cemented with 75 Sacks Cement

RECEIVED  
STATE CORPORATION COMMISSION  
JUN - 8 1966  
CONSERVATION DIVISION  
Wichita, Kansas

CABLE TOOLS RECORD: Cleaned out to rotary total depth, 3417'. After 3 hours, hole filled 2200 ft. Swabbing averaging 8 bbls. per hour. Putting on pump.