

STATE OF KANSAS  
STATE CORPORATION COMMISSION


Form CP-4

WELL PLUGGING RECORD

Give All Information Completely  
Make Required A...  
Mail or Deliver Report to:  
Conservation Division  
State Corporation Commission  
211 No. Broadway  
Wichita, Kansas

Rice County. Sec. 4 Typ. 21 Rge. 6 (E) W (W)

NORTH

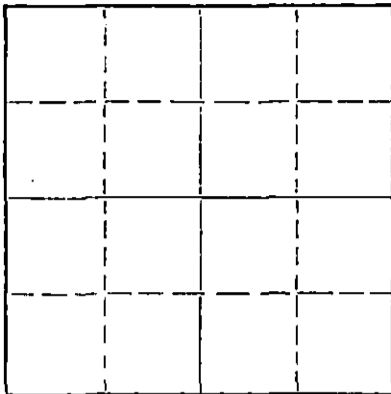

Locate well correctly on above  
Section Plat

Location as "NE/CNW/SW" or footage from lines SE NW NW  
Lease Owner Sterling Drilling Company  
Lease Name Clevenger Well No. 7  
Office Address Sterling, Kansas  
Character of Well (completed as Oil, Gas or Dry Hole) \_\_\_\_\_  
Date well completed \_\_\_\_\_ 19\_\_\_\_  
Application for plugging filed \_\_\_\_\_ 19\_\_\_\_  
Application for plugging approved \_\_\_\_\_ 19\_\_\_\_  
Plugging commenced 3-31-66 \_\_\_\_\_ 19\_\_\_\_  
Plugging completed 4-1-66 \_\_\_\_\_ 19\_\_\_\_  
Reason for abandonment of well or producing formation Depleted.

If a producing well is abandoned, date of last production \_\_\_\_\_ 19\_\_\_\_  
Was permission obtained from the Conservation Division or its agents before plugging was commenced? yes

Name of Conservation Agent who supervised plugging of this well Gilbert Toman  
Producing formation \_\_\_\_\_ Depth to top \_\_\_\_\_ Bottom \_\_\_\_\_ Total Depth of Well 3427 Feet  
Show depth and thickness of all water, oil and gas formations.

OIL, GAS OR WATER RECORDS

CASING RECORD

FORMATION	CONTENT	FROM	TO	SIZE	PUT IN	PULLED OUT
				8-5/8"	175'	None
				5-1/2"	3419'	3124'

Describe in detail the manner in which the well was plugged, indicating where the mud fluid was placed and the method or methods used in introducing it into the hole. If cement or other plugs were used, state the character of same and depth placed, from \_\_\_\_\_ feet to \_\_\_\_\_ feet for each plug set.

3427'  
Checked hole, sanded hole from 3427' to 3400' and dump  
dumped 5 sacks of cement @ 3400' with dump bailer.  
Pulled 5 1/2" casing, checked fluid to 400', mudded  
to 210', set rock bridge to 200' and dumped 25  
sacks of cement @ 200'. Mudded hole to 40', set  
rock bridge to 30' and ran 10 sacks of cement to  
base of cellar.

RECEIVED  
STATE CORPORATION COMMISSION  
APR 6 1966  
CONSERVATION DIVISION  
Wichita, Kansas

PLUGGING COMPLETE.

(If additional description is necessary, use BACK of this sheet)

Name of Plugging Contractor KNIGHT CASING PULLING COMPANY  
Address CHASE, KANSAS

STATE OF KANSAS COUNTY OF RICE, ss.  
Noel J. Knight (employee of owner) or (owner or operator) of the above-described well, being first duly sworn on oath, says: That I have knowledge of the facts, statements, and matters herein contained and the log of the above-described well as filed and that the same are true and correct. So help me God.

(Signature) Noel J. Knight  
Chase, Kansas  
(Address)

SUBSCRIBED AND SWORN TO before me this 4th day of April, 1966

My commission expires May 20, 1968 Milton J. Tolin Notary Public.

STERLING DRILLING COMPANY  
Sterling, Kansas

WELL LOG-----CLEVINGER #7

Location: SE NW NW, Section 4-21S-6W,  
Rice County, Kansas

OWNER: Seeger Oil and Gas Company, Inc.  
ROTARY DRILLING CONTRACTOR: Sterling Drilling Company  
CABLE TOOL CONTRACTOR: Sterling Drilling Company

RECEIVED  
STATE CORPORATION COMMISSION

MAR 25 1966

CONSERVATION DIVISION  
Wichita, Kansas

COMMENCED: 4-19-56 (w.r.)  
5-2-56 (w.o.t.)  
COMPLETED: 4-30-56 (w.r.)  
5-9-56 (w.o.t.)

TOTAL DEPTH: 3423'

LOG

0-286	Sand & Shale
286-650	Shale
650-1240	Shale & Limestone
1240-1585	Limestone
1585-1905	Limestone & Shale
1905-2105	Shale
2105-2259	Shale & Limestone
2259-2715	Limestone
2715-2850	Shale & Limestone
2850-3190	Limestone
3190-3205	Shale
3205-3320	Shale & Limestone
3320-3409	Shale
3409-3423	Chat T.D.

CASING RECORD

Ran 175' of 8-5/8" casing set with  
125 sacks cement and 2 sacks calcium  
chloride.

Set 5-1/2" casing at 3419' with 50  
sacks cement.

CABLE TOOLS M.I.C.T. Rigged up and swabbed hole down. Drilled new hole to 3427'.  
Fractured with 180 bbls. heavy oil and 15,000# sand. Swab tested at the rate of  
30 B.O.P.H. P.O.P.