

STATE OF KANSAS  
STATE CORPORATION COMMISSION

## WELL PLUGGING RECORD

**OR**

## FORMATION PLUGGING RECORD

**Strike out upper line when reporting plugging off formations.**

**Give All Information Completely**  
**Make Required Affidavit**  
**Mail or Deliver Report to:**  
**Conservation Division**  
**State Corporation Commission**  
**300 Bittig Building**  
**Wichita, Kansas**

NORTH


**Locate well correctly on above  
Section Plat**

Rice County. Sec. 4 Twp. 21s Rge. (E) 6 (W)

Location as "NE $\frac{1}{4}$ NW $\frac{1}{4}$ SW $\frac{1}{4}$ " or footage from lines NW SE NW

Lease Owner Sterling Petroleum, Inc.

Lease Name Alexander Well No. 1

Office Address Bitting Bldg., Wichita, Kansas

Character of Well (completed as Oil, Gas or Dry Hole) Dry Hole

Date well completed April 27, 1948

Application for plugging filed April 28, 1948

Application for plugging approved April 28, 1948

Plugging commenced April 28, 1948

Plugging completed May 2, 1948

Reason for abandonment of well or producing formation Dry Hole

If a producing well is abandoned, date of last production 19

Was permission obtained from the Conservation Division or its agents before plugging was commenced? Yes

Name of Conservation Agent who supervised plugging of this well..... Elden Petty.....  
Producing formation..... Depth to top..... Bottom..... Total Depth of Well..... 3498'..... Feet  
Show depth and thickness of all water, oil and gas formations.

## OIL, GAS OR WATER RECORDS

### CASING RECORD

[illegible]

Describe in detail the manner in which the well was plugged, indicating where the mud fluid was placed and the method or methods used in introducing it into the hold. If cement or other plugs were used, state the character of same and depth placed, from.....feet to .....feet for each plug set.

Filled to bottom of pipe with Gravel and 5 sacks cement. Bridge at 193 with 15 sacks cement, then come to top and filled in with 10 sacks cement.

(If additional description is necessary, use BACK of this sheet)

Correspondence regarding this well should be addressed to..... Sterling Drilling Company  
Address..... Sterling, Kansas

STATE OF KANSAS, COUNTY OF RICE, ss.  
Rollin Mead (employee of owner) or (owner or operator) of the above-described well,  
 being first duly sworn on oath, says: That I have knowledge of the facts, statements, and matters herein contained and the log of the above-described well as filed and that the same are true and correct. So help me God.

(Signature)


Sterling, Kansas

(Address)

SUBSCRIBED AND SWORN to before me this 5th day of May, 1948.

My commission expires September 17, 1949.

.....  
Notary Public.

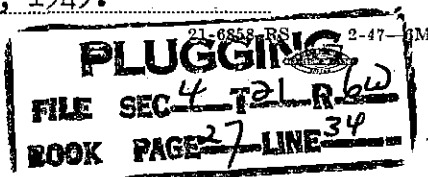

WELL LOG

ALEXANDER NO. 1

Location - NW SE NW of Section 4-21S-6W, Rice County, Kansas.

Owner - Sterling Petroleum, Inc.

Contractor - Sterling Drilling Company

Commenced - April 10, 1948

Completed - April 20, 1948 (w/r)

May 2, 1948 (plugged &amp; abandoned)

Total Depth - 3347' (w/r)

3497' (c/t)

ELEVATION - 1629 D.F.

LOGCASING RECORD

0- 70	Surface, Sand & Clay
70- 120	Red Bed
120- 195	Shale & Shells
195- 300	Red Bed
300- 620	Shale
620- 825	Shale & Salt
825- 950	Shale & Shells
950-1350	Shale & Lime
1350-1470	Lime
1470-1785	Lime & Shale
1785-2120	Shale
2120-2245	Shale & Shells
2245-2340	Shale
2340-2660	Lime
2660-2780	Shale
2780-3275	Lime
3275-3415	Shale & Lime
3415-3444	Shale
3444-3447	Chatt
3447-3497	Cable Tools

195' 8-5/8" Surface Pipe  
Cemented with 125 Sacks Cement

3448' 5 1/2-inch O.D. Casing  
(Set at 3441)  
Cemented with 50 Sacks Cement

PRODUCTION

None.....Dry &amp; Abandoned.

MAY 8 - 1948

