

STATE OF KANSAS
STATE CORPORATION COMMISSION


WELL PLUGGING RECORD

OR

FORMATION PLUGGING RECORD

Strike out upper line
when reporting plug-
ging off formations.Give All Information Completely
Make Required Affidavit
Mail or Deliver Report to:
Conservation Division
State Corporation Commission
800 Bittling Building
Wichita, Kansas

NORTH

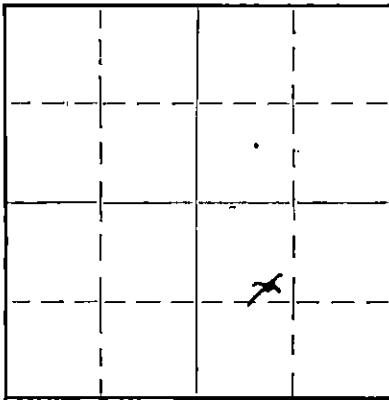Locate well correctly on above
Section Plat

Rice County. Sec. 3 Twp. 21 Rge. (E) 6 (W)
Location as "NE $\frac{1}{4}$ NW $\frac{1}{4}$ SW $\frac{1}{4}$ " or footage from lines. W $\frac{1}{2}$ -SE $\frac{1}{4}$
Lease Owner. D. E. CARPENTER Eml
Lease Name. RAINEY Well No. 4A
Office Address. 17 W-12th St Hutchinson Kans
Character of Well (Completed as Oil, Gas or Dry Hole) Rock + Abandoned
Date, well completed Rock + Abandoned about 1933
Application for plugging filed. 2-1-40 1933
Application for plugging approved. 1933
Plugging Commenced. 2-1-40 1933
Plugging Completed. 2-1-40 1933
Reason for abandonment of well or producing formation. Hole lost

If a producing well is abandoned, date of last production. — 1933
Was permission obtained from the Conservation Division or its agents before plugging was com-
menced? yes

Name of Conservation Agent who supervised plugging of this well. RUEH DURKEE
Producing formation. — Depth to top. — Bottom. — Total Depth of Well 2050 Feet.
Show depth and thickness of all water, oil and gas formations.

OIL, GAS OR WATER RECORDS



CASING RECORD

Formation	Content	From	To	Size	Put In	Pulled Out
<u>Nothing only</u> <u>the fresh water</u>				<u>15 1/2</u>	<u>95</u>	<u>Left in</u>

Describe in detail the manner in which the well was plugged, indicating where the mud fluid was placed and the method or methods used in introducing it into the hole. If cement or other plugs were used, state the character of same and depth placed, from. feet to feet for each plug set.

Rock + Cement plug placed at 220 in about 1933

2-1-40 Filled with heavy mud from 220 to 12 and
Cemented with 18 bag cement.

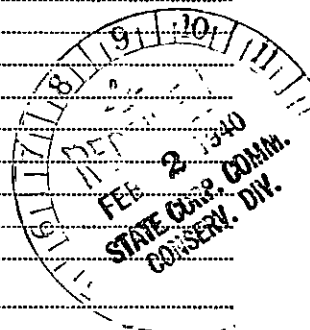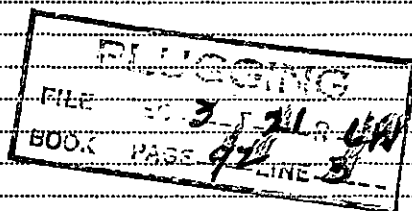

(If additional description is necessary, use BACK of this sheet)

Correspondence regarding this well should be addressed to. D. E. Carpenter
Address. 17 W 12th St Hutchinson Kans

STATE OF Kansas, COUNTY OF Reno, ss.

D. E. Carpenter (employee of owner) or (owner or operator) of the above-described well,
being first duly sworn on oath, says: That I have knowledge of the facts, statements, and matters herein contained and the log of the above-
described well as filed and that the same are true and correct. So help me God.

(Signature)

D. E. Carpenter17-W-12th St Hutchinson, Kans.

(Address)

SUBSCRIBED AND SWORN to before me this 1st day of February, 1940

My commission expires Nov. 4, 1943

17-6058

10-38-5M

Notary Public.

T-16.