


WELL PLUGGING RECORD

Give All Information Completely
Make Required Affidavit
Mail or Deliver Report to:
Conservation Division
State Corporation Commission
800 Blitting Building
Wichita, Kansas

NORTH

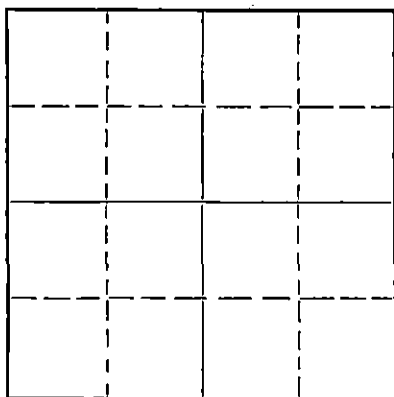

Locate well correctly on above Section Flat

Stafford County. Sec. 36 Twp. 21 Rge. (E) 12 (W)
Location as "NE/CNW 1/4 SW 1/4" or footage from lines NE NE NE
Lease Owner Iron Drilling Co.
Lease Name E. H. Mellies Well No. 1
Office Address 1206 Philtower, Tulsa, Oklahoma
Character of Well (completed as Oil, Gas or Dry Hole) Dry Hole
Date well completed May 5 19 51
Application for plugging filed " 19 51
Application for plugging approved " 19 51
Plugging commenced " 19 51
Plugging completed " 19 51
Reason for abandonment of well or producing formation.

If a producing well is abandoned, date of last production 19
Was permission obtained from the Conservation Division or its agents before plugging was commenced? Yes

Name of Conservation Agent who supervised plugging of this well Harold J. Hollis
Producing formation None Depth to top Bottom Total Depth of Well Feet
Show depth and thickness of all water, oil and gas formations.

OIL, GAS OR WATER RECORDS

CASING RECORD

Formation	Content	From	To	Size	Put In	Pulled Out
Lansing		3206		9-5/8"	280	None
Penn Chert Cong		3500				
Simpson		3510				
Arbuckle		3555				

Describe in detail the manner in which the well was plugged, indicating where the mud fluid was placed and the method or methods used in introducing it into the hole. If cement or other plugs were used, state the character of same and depth placed, from feet to feet for each plug set.

RECEIVED
STATE CORPORATION COMMISSION
MAY 19 1951
CONSERVATION DIVISION
Wichita, Kansas

(If additional description is necessary, use BACK of this sheet)

Correspondence regarding this well should be addressed to Address

STATE OF Oklahoma, COUNTY OF Tulsa, ss.
Herrick Babcock (employee of owner) or (owner or operator) of the above-described well,
being first duly sworn on oath, says: That I have knowledge of the facts, statements, and matters herein contained and the log of the above-described well as filed and that the same are true and correct. So help me God.
(Signature) Herrick Babcock
1206 Philtower Bldg., Tulsa, Okla.
(Address)

SUBSCRIBED AND SWORN to before me this 17th day of May, 19 51

Feb. 28, 1952

B. Michal

Notary Public.

My commission expires

PLUGGING
FILE SEC 36 T 21 R 12 W
BOOK PAGE 81 LINE 7

DRILLING RECORD

Fred Mellies Well No. 1
NE NE NE 36-21-12W
Stafford County, Kansas

Casing Record

200' of 9-5/8" OD Surface
Pipe cemented with 200 sacks.

Work Commenced 4/20/51
Drilling Commenced 4/22/51
Drilling Completed 5/5/51
Work Completed 5/6/51

No Oil String - Dry Hole

Well Log

Clay & Red Bed	0 to 245
Shale & Shells	245 to 330
Red Bed	330 to 530
Anhydrite	530 to 545
Anhydrite & Shale	545 to 825
Shale & Shells	825 to 1130
Lime & Shale	1130 to 1460
Anhydrite & Shale Streaks	1460 to 1555
Lime & Shale	1555 to 1740
Lime & Shale Streaks	1740 to 1817
Lime & Shale	1817 to 2160
Shale & Shells	2160 to 2500
Shale & Lime	2500 to 2600
Shale & Lime Shells	2600 to 2725
Shale & Lime	2725 to 3211
Lime	3211 to 3502
Conglomerate	3502 to 3523
Lime	3523 to 3606 TD

CERTIFICATION

State of Oklahoma, County of Tulsa, SS.

I, Herrick Babcock, Partner of Iron Drilling Company, Certify that the above is a true and correct log of the above described well.

Signature

Herrick Babcock

Subscribed to and Sworn before me this 18th day of May, 1951.

RECEIVED
STATE CORPORATION COMMISSION

MAY 19 1951

D. W. ...
CONSERVATION DIVISION
Notary Public, Kansas

My commission expires Feb. 28, 1952.

PLUGGING
PAGE 31 of 81
BOOK PAGE 8 LINE 7