


Give All Information Completely
Make Required Affidavit
Mail or Deliver Report to:
Conservation Division
State Corporation Commission
211 No. Broadway
Wichita, Kansas

WELL PLUGGING RECORD

NORTH

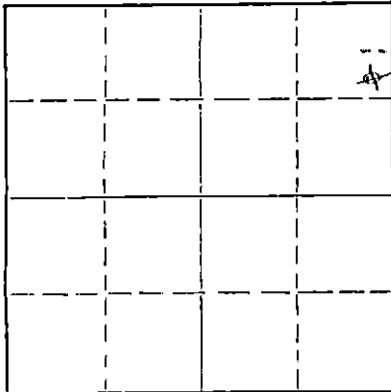

Locate well correctly on above
Section Plat

Stafford County. Sec. 29 Twp. 21s Rge. 12w (E) (W)

Location as "NE/CNW4SW4" or footage from lines. SE NE NE

Lease Owner Virginia Drilling Co Inc.

Lease Name ~~St. Ahlgrim~~ Well No. 1

Office Address 712 Brown Bldg. Wichita, Kans 67202

Character of Well (completed as Oil, Gas or Dry Hole) dry hole

Date well completed Oct. 29, 1965 19

Application for plugging filed " 19

Application for plugging approved " 19

Plugging commenced " 19

Plugging completed " 19

Reason for abandonment of well or producing formation

If a producing well is abandoned, date of last production 19

Was permission obtained from the Conservation Division or its agents before plugging was commenced? yes

Name of Conservation Agent who supervised plugging of this well A. Elving, Pratt, Kans

Producing formation Depth to top Bottom Total Depth of Well 3670 Feet

Show depth and thickness of all water, oil and gas formations.

OIL, GAS OR WATER RECORDS

CASING RECORD

FORMATION	CONTENT	FROM	TO	SIZE	PUT IN	PULLED OUT
		0	279	8 5/8"	278	none

Describe in detail the manner in which the well was plugged, indicating where the mud fluid was placed and the method or methods used in introducing it into the hole. If cement or other plugs were used, state the character of same and depth placed, from feet to feet for each plug set.

Mudded to 260' - set plug w/25 sx cement
" " 40' - set plug w/11 sx cement 1/2 sx hulls
2 sx cement in rat hole

RECEIVED
STATE CORPORATION COMMISSION

NOV 5 1965

CONSERVATION DIVISION
STATE CORPORATION COMMISSION

(If additional description is necessary, use BACK of this sheet)

Name of Plugging Contractor Virginia Drilling Co Inc.

Address 712 Brown Bldg. Wichita, Kans 67202

STATE OF Kansas, COUNTY OF Stafford, ss.

S. A. Murphy (employee of owner) or (owner or operator) of the above-described well, being first duly sworn on oath, says: That I have knowledge of the facts, statements, and matters herein contained and the log of the above-described well as filed and that the same are true and correct. So help me God.

(Signature) S. A. Murphy
712 Brown Bldg. Wichita, Kans 67202
(Address)

SUBSCRIBED AND SWORN TO before me this 2nd day of November, 1965

My commission expires Febr. 5, 1969

Murlee Hawkins
Notary Public.



AHLGRIM #1 - SE NE NE Section 29-21s-12w Stafford County, Kas.
 Company - Virginia Drikling Co Inc.
 Contractor - same
 Commenced - October 19, 1965
 Completed - October 29, 1965
 Elevation - 1865 KB
 Total Depth

8 5/8" set at 278 w/250 cu ft pozmix

FORMATION ----- DEPTH -----

Sand	0 - 215	TOPS:
Shale-shells	215 - 279	
Shale - redrock	279 - 664	664 - Anhydrite
Anhydrite	664 - 690	3140 - Heebner
Shale-shells	690 - 1665	3158 - Toronto
Lime-shale	1665 - 2175	3174 - Douglas
Shale-shells	2175 - 2615	3273 - Brn lime
Lime-shale	2615 - 3336	3288 - Lansing
Lime	3336 - 3380	3522 - Conglomerate
Lime-shale	3380 - 3575	3536 - 3635 - Viola
Simpson	3575 - 3630	3575 - Simpson
Arbuckle	3630 - 3670 TD	3630 - Arbuckle

S. A. Murphy

 S. A. Murphy

Subscribed and sworn to before me, a Notary Public, this
 2nd day of November, 1965.

Murlee Hawkins

 Murlee Hawkins - Notary Public

My commission expires: Febr. 5, 1969.

RECEIVED
 STATE CORPORATION COMMISSION

NOV 5 1965

CONSERVATION DIVISION
 Wichita, Kansas