

STATE OF KANSAS
STATE CORPORATION COMMISSION

WELL PLUGGING RECORD

OR

FORMATION PLUGGING RECORD


Strike out upper line
when reporting plug-
ging off formations.

Give All Information Completely
Make Required Affidavit
Mail or Deliver Report to:
Conservation Division
State Corporation Commission
809 Bittling Building
Wichita, Kansas

Stafford County, Sec. 29, Twp. 21S, Rge. 12 (E) (W)

Location as "NE 1/4 NW 1/4 SW 1/4" or footage from lines NE 1/4 NE 1/4 SW 1/4
Lease Owner I. K. Owens & Virginia Drilling Co., Inc.
Lease Name Teipermann Well No. 1
Office Address 314 Butts Bldg., Wichita, Kansas
Character of Well (Completed as Oil, Gas or Dry Hole) Dry
Date, well completed July 28, 1939
Application for plugging filed August 3, 1939
Application for plugging approved August 3, 1939
Plugging Commenced August 3, 1939
Plugging Completed August 9, 1939
Reason for abandonment of well or producing formation Dry

NORTH

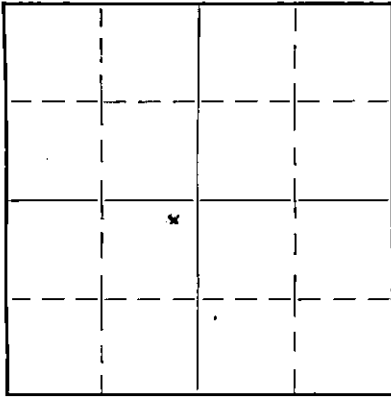

Locate well correctly on above
Section Plat

If a producing well is abandoned, date of last production 193
Was permission obtained from the Conservation Division or its agents before plugging was com-
menced? yes

Name of Conservation Agent who supervised plugging of this well Ruel Durkee, Lyons, Kansas

Producing formation Depth to top Bottom Total Depth of Well 3639 Feet.

Show depth and thickness of all water, oil and gas formations.


OIL, GAS OR WATER RECORDS

CASING RECORD

Formation	Content	From	To	Size	Put In	Pulled Out
				8 1/4	240	
				5 1/2	3610	1300

Describe in detail the manner in which the well was plugged, indicating where the mud fluid was placed and the method or methods used in introducing it into the hole. If cement or other plugs were used, state the character of same and depth placed, from feet to feet for each plug set.

Plugged with cement from 3604 to 3639. Filled with mud from 240 to 3604.
Cement and rock from 225 to 240 and filled with mud 10 feet from top. 10 ft.
cement plug on top of surface casing.

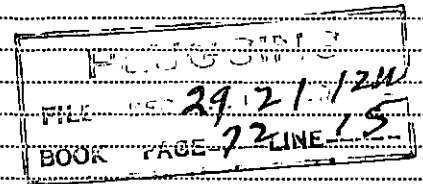

(If additional description is necessary, use BACK of this sheet)

Correspondence regarding this well should be addressed to Virginia Drilling Company, Inc.,
Address 314 Butts Bldg., Wichita, Kansas

STATE OF Kansas, COUNTY OF Sedgwick, ss.
S. A. Murphy (employee of owner) or (owner or operator) of the above-described well,

being first duly sworn on oath, says: That I have knowledge of the facts, statements, and matters herein contained and the log of the above-described well as filed and that the same are true and correct. So help me God.

(Signature) S. A. Murphy

314 Butts Bldg., Wichita, Kansas (Address)

SUBSCRIBED AND SWORN to before me this 12th day of August, 1939

My commission expires February 5, 1941.

Muslee Hawkins
Notary Public.


Teipermann # 1 - NE $\frac{1}{4}$ NE $\frac{1}{4}$ SW $\frac{1}{4}$ of Section 29-21S-12W Stafford County, Kansas
 Company - I. K. Owens & Virginia Drilling Company, Inc.
 Contractor - Virginia Drilling Company, Inc.
 Commenced - June 19, 1939
 Completed - July 28, 1939
 Elevation - 1863
 Total Depth - 3639
 Completed as Dry Hole.

FORMATION	DEPTH
Sand, Gravel & Shale	40- 254
Reamed 9" hole O-240 Set 240' of 8 $\frac{1}{4}$ " casing.	
Red Rock, Sand & Shale	240- 490
Red Rock & Sand	490- 660
Anhydrite	660- 695
Red Bed	695- 720
Red Bed, Shale & Shells	720- 920
Shale & Shells	920-1130
Shale & Lime	1130-1405
Shale	1405-1450
Lime & Shale	1450-1500
Anhydrite	1500-1520
Lime	1520-1675
Broken Lime	1675-1690
Lime	1690-1755
Lime & Shale	1755-1875
Lime	1875-1915
Lime & Shale	1915-1940
Lime	1940-2005
Lime & Shale	2005-2219
Sandy Lime	2219-2239
Shale & Lime	2239-2860
Lime	2860-2956
Shale	2956-2985
Lime	2985-3010
Lime & Shale	3010-3045
Lime	3045-3154
SIM correction- 3154 equals 3159	
Shale & Lime	3159-3227
Shale	3227-3260
Top K. C. 3260	
Lime	3260-3386
Coring 3386-3392	
Reaming Core 3386-3392	
Show of oil & gas	
Lime	3392-3475
Lime & Shale	3475-3495
Chert, Lime & Shale	3495-3515
Top Conglomerate-3500	
Chert, Lime	3515-3530
Chert & Shale	3530-3562
SIM correction: 3562 equals 3560	
Chert & Shale	3560-3586
Top Simpson - 3584	
Top Viola - 3586	
Shale	3586-3614
Coring 3614-3618	
Recovery:	
1 foot saturated dolomite	
3 feet broken dolomite & green shale, all saturated	
Run 3610' of 5 $\frac{1}{2}$ " D.D. casing	
Top Siliceous Lime 3610	

FORMATION	DEPTH
Acidized with 110 gals.	
" " 500 "	
Lime	3617-3622
Acidized with 400 gals.	
Lime	3622-3626
Swabbed 1 bbl. per hr.	
Lime	3626-3639
Hole full water 3637-3639	
T. D. 3639	

Now comes S. A. Murphy, who states that he is familiar with the drilling of oil and gas wells and that he knows personally that the Teipermann # 1 in NE $\frac{1}{4}$ NE $\frac{1}{4}$ SW $\frac{1}{4}$ of Section 29-21S-12W Stafford County, Kansas, was drilled to a total depth of 3639 feet, water being found in the Siliceous Lime. Same was plugged and abandoned.

S. A. Murphy

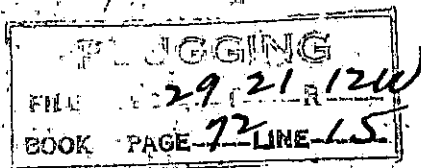

Subscribed to and sworn to before me this 12th day of August, 1939.

Muskie Hawkins
Notary Public

My commission expires February 5, 1941.