

9P


STATE OF KANSAS
STATE CORPORATION COMMISSION

Form CP-4

Give All Information Completely
Make Required Affidavit
Mail or Deliver Report to:
Conservation Division
State Corporation Commission
212 No. Market
Wichita, Kansas 67202

WELL PLUGGING RECORD

Stafford County, Sec. 29 Twp. 21 Rge. 12W (E) (W)
Location as "NE/CNW/SW" or footage from lines NW SE SW
Lease Owner ~~KXXXXXXXXXXX~~ Sitrin Petroleum Corporation
Lease Name Teiperman A#8 Well No.
Office Address Great Bend, Kansas 67530
Character of Well (completed as Oil, Gas or Dry Hole)
Date well completed 19
Application for plugging filed 19
Application for plugging approved 19
Plugging commenced 5/13/71 19
Plugging completed 5/21/71 19
Reason for abandonment of well or producing formation depleted
If a producing well is abandoned, date of last production 19
Was permission obtained from the Conservation Division or its agents before plugging was commenced? YES

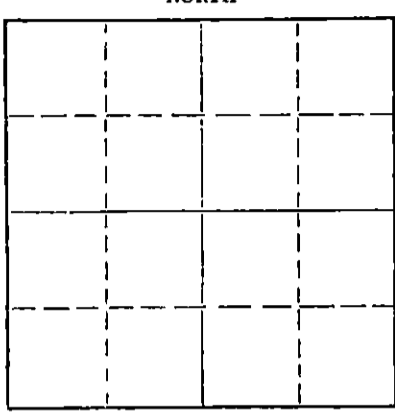

Locate well correctly on above Section Plat

Name of Conservation Agent who supervised plugging of this well Biberstein
Producing formation Depth to top Bottom Total Depth of Well 3651 Feet
Show depth and thickness of all water, oil and gas formations.

OIL, GAS OR WATER RECORDS				CASING RECORD		
FORMATION	CONTENT	FROM	TO	SIZE	PUT IN	PULLED OUT
				8-5/8	290	none
				5 1/2"	3651'	1801'

RECEIVED
STATE CORPORATION COMMISSION
JUN 7 1971
CONSERVATION DIVISION
Wichita, Kansas

Describe in detail the manner in which the well was plugged, indicating where the mud fluid was placed and the method or methods used in introducing it into the hole. If cement or other plugs were used, state the character of same and depth placed, from feet to feet for each plug set.

Checked hole to 3651', ran sand to 3575', ran 5 sacks of cement.
Shot pipe at 3000', 2904', pipe parted, pulled 13 joints, 400'.
Got overshot and ran pipe in, couldn't get hooked on. Pulled pipe, ran overshot, couldn't get hooked on, pulled overshot and ran another one. Checked hole to 2600'. Pulled overshot, got another one and ran, got on pipe, shot pipe at 2496', 2284', 2284', couldn't get loose.
Shot pipe at 2096', 2000', 1908', 1806', got loose and pulled 57 joints.
Bailed hole to 240', set 10' rock bridge and ran 4 yards concrete. Racked unit and tallied pipe.

PLUGGING COMPLETE.

(If additional description is necessary, use BACK of this sheet)
Name of Plugging Contractor KNIGHT CASING PULLING CO., INC.
Address CHASE, KANSAS

STATE OF KANSAS, COUNTY OF RICE, ss.
NOEL J. KNIGHT (employee of owner) or (owner or operator) of the above-described well, being first duly sworn on oath, says: That I have knowledge of the facts, statements, and matters herein contained and the log of the above-described well as filed and that the same are true and correct. So help me God.

(Signature) Noel Knight
CHASE, KANSAS
(Address)

Subscribed and sworn to before me this 3rd day of June, 1971
MARGARET MELCHER
NOTARY PUBLIC
Rice County, Kansas
My Commission Expires Feb. 15, 1975

Margaret Melcher
Notary Public.

Well: Teiperman "A" No. 8
 Location: NW SE SW Sec. 29-21-12, Stafford Co., Kansas
 Company: S. A. Murphy
 Contractor: Virginia Drilling Co., Inc.
 Commenced: July 6, 1950
 Completed: August 9, 1950
 Total Depth: 3651 1/2
 Elevation: 3478

no geol. report S.A.M. on well

FORMATION	DEPTH
Surface soil-sand	0-227
Shell-shale	227-270
Red Bed	270-290
Red Bed-shell	290-660
Anhydrite	660-690
Red Bed-shale	690-980
Shale-shells	980-1200
Salt	1200-1255
Salt-shale	1255-1430
Shale-shells	1430-1670
Lime-shale	1670-1730
Lime-sand-shale	1730-1835
Shale-lime	1835-2035
Lime	2035-2080
Lime-shale	2080-2935
Lime	2935-2985
Lime-shale	2985-3095
Lime	3095-3140
Lime-shale	3140-3260
Lime	3260-3420
Lime-shale strks.	3420-3470
Lime-shale	2470-3500
Chert Lime	3500-3520
Lime	3520-3550
Shale	3550-3585
Shale-sand	3585-3596
Lime	3596-3651 1/2

Set 290' of 8-5/8" csg.
 Set 5 1/2" csg. @ 3651

TOPS:

Topeka	2741
Kansas City	3254
Arbuckle	3594

RECEIVED
 STATE CORPORATION COMMISSION
 MAY 3 1971
 CONSERVATION DIVISION
 Wichita, Kansas

Now comes S. A. Murphy, who states that he is familiar with the drilling of oil and gas wells and knows of his own knowledge that the Teiperman "A" No. 8, located in the NW SE SW, Sec. 29-21-12, Stafford Co., Kansas, was drilled to a total depth of 3651 1/2 feet, arbuckle being found at 3594 feet.

S.A. Murphy

Subscribed and sworn to before me this 12th day of October, 1950.

J. M. Newman
 Notary Public

My commission expires March 15, 1954.

*Same wells - broke 3617-3610
 12" 3606-3607
 24" 3598-3590
 1500' fillup - no water*

Oct 1953 - Clean out well acid - 500 gal.