


WELL PLUGGING RECORD

Give All Information Completely
Make Required Affidavit
Mail or Deliver Report to:
Conservation Division
State Corporation Commission
800 Bittling Building
Wichita, Kansas

NORTH

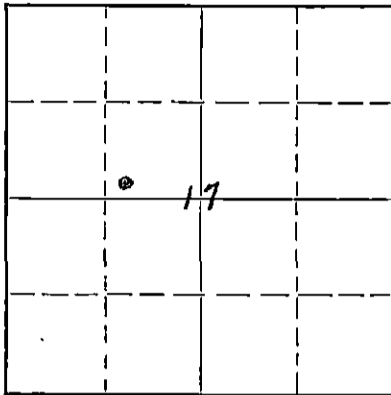

Locate well correctly on above
Section Plat

Stafford County. Sec. 17 Twp. 21 Rge. (E) 13 (W)
Location as "NE/CNW $\frac{1}{4}$ /SW $\frac{1}{4}$ " or footage from lines SW SE NW
Lease Owner Cities Service Oil Company
Lease Name Fischer "B" Well No. 1
Office Address Bartlesville, Oklahoma
Character of Well (completed as Oil, Gas or Dry Hole) Dry Hole
Date well completed March 13, 19.51
Application for plugging filed March 13, 19.51
Application for plugging approved March 13, 19.51
Plugging commenced March 13, 19.51
Plugging completed March 13, 19.51
Reason for abandonment of well or producing formation Dry Hole

If a producing well is abandoned, date of last production _____ 19____
Was permission obtained from the Conservation Division or its agents before plugging was commenced? Yes

Name of Conservation Agent who supervised plugging of this well G. D. Stough
Producing formation _____ Depth to top _____ Bottom _____ Total Depth of Well 3732 Feet
Show depth and thickness of all water, oil and gas formations.

OIL, GAS OR WATER RECORDS

CASING RECORD

Formation	Content	From	To	Size	Put In	Pulled Out
				8-5/8"	386'	None

Describe in detail the manner in which the well was plugged, indicating where the mud fluid was placed and the method or methods used in introducing it into the hole. If cement or other plugs were used, state the character of same and depth placed, from 350 feet to 300 feet for each plug set.

3732' - 350', heavy mud
350' - 300', wood plug and 15 sacks cement
300' - 35', mud
35' to base of cellar, 10 sacks cement.

RECEIVED
STATE CORPORATION COMMISSION
MAR 23 1951
CONSERVATION DIVISION
WICHITA, KANSAS

(If additional description is necessary, use BACK of this sheet)
Correspondence regarding this well should be addressed to R. C. Cooper
Address Box 751
Great Bend, Kansas

STATE OF Kansas, COUNTY OF Barton, ss.
V. M. Conover (employee of owner) of the above-described well,
being first duly sworn on oath, says: That I have knowledge of the facts, statements, and matters herein contained and the log of the above-described well as filed and that the same are true and correct. So help me God.

(Signature) *V. M. Conover*
Box 751, Great Bend, Kansas
(Address)

SUBSCRIBED AND SWORN TO before me this 16th day of March, 19.51

My commission expires March 12, 1955. *W. G. Smith* Notary Public.

PLUGGING
FILE SEC-17 T. 21 R. 13W
BOOK PAGE 67 LINE 8

WELL RECORD

15.185.10613.0000

Company Cities Service Oil Co. Well No. 1 Farm Fischer #98
 Location 330' North and 990' West of Center Sec. 17 T. 21 R. 13W
 Elevation 1912 (1910 Gr.) County Stafford State Kansas
 Drlg. Comm. March 3, 1951 Contractor Holm Drilling Company
 Drlg. Comp. March 13, 1951 Acid None
 T. D. 3732' Initial Prod. None - Dry Hole; P. & A. 3-13-51.

CASING RECORD:

8-5/8" @ 300' con. w/ 250 sacks cement

FORMATION RECORD:

sand & clay	0-50
shale & shells	530
shale	370
red bed & shale	895
anhedrite	635
shale & shells	1235
salt & shale	1510
shale & shells	1695
lime & shale	2350
shale & lime	2570
shale	2740
lime & shale	3175
lime	3177
lime & shale	3255
shale	3340
lime	3593
chart and shale	3654
lime	3670
shale & lime	3687
shale & lime & sand	3708
lime	3732 f. d.

Top Lansing	3350'
Top Cherty Congl.	3590'
Top Viola	3593'
Top Simpson Shale	3643'
Top Simpson Sand	3658'
Top Arbuckle	3703'
Penetration	30'
Total Depth	3732'

TYPE:	500'	1°
	1000'	1°
	1500'	1°
	2000'	1°
	2500'	1°
	3000'	1°
	3500'	1°

Drill stem test 3704-06, recovered
 20' rotary mud, no oil, no water,
 in 30 mins.

RECEIVED
 STATE CORPORATION COMMISSION

MAR 23 1951
PLUGGING
 FILE SEC. 17.21.132
 BOOK PAGE 67 LINE 6