


WELL PLUGGING RECORD

Give Information Completely
Make Required Affidavit
Mail or Deliver Report to:
Conservation Division
State Corporation Commission
800 Bitting Building
Wichita, Kansas

NORTH

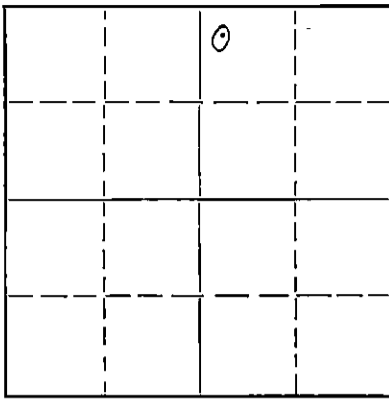

Locate well correctly on above
Section Plat

Stafford County. Sec. 17 Twp. 21 Rge. (E) 13 (W)
Location as "NE/CNW 1/4 SW 1/4" or footage from lines 2310' E. & 330' S. of Center
Lease Owner Cities Service Oil Company
Lease Name Walters Well No. 3
Office Address Bartlesville, Oklahoma
Character of Well (completed as Oil, Gas or Dry Hole) Dry Hole
Date well completed June 1, 19 52
Application for plugging filed June 1, 19 52
Application for plugging approved June 1, 19 52
Plugging commenced June 1, 19 52
Plugging completed June 1, 19 52
Reason for abandonment of well or producing formation Dry Hole

If a producing well is abandoned, date of last production ---- 19
Was permission obtained from the Conservation Division or its agents before plugging was commenced? Yes

Name of Conservation Agent who supervised plugging of this well M. A. Rives
Producing formation Depth to top Bottom Total Depth of Well 3805 Feet
Show depth and thickness of all water, oil and gas formations.

OIL, GAS OR WATER RECORDS

CASING RECORD

Formation	Content	From	To	Size	Put In	Pulled Out
				8-5/8"	355'	None

Describe in detail the manner in which the well was plugged, indicating where the mud fluid was placed and the method or methods used in introducing it into the hole. If cement or other plugs were used, state the character of same and depth placed, from feet to feet for each plug set.

3805' - 300', heavy mud
300' - 250', wood plug and 15 sacks cement
250' - 35', mud
35' - base of cellar, wood plug and 10 sacks cement.

(If additional description is necessary, use BACK of this sheet)

Name of Plugging Contractor Peak Drilling Company
Address Wichita, Kansas

STATE OF Kansas, COUNTY OF Barton, ss.
V. M. Conover (employee of owner) or (owner or operator) of the above-described well,
being first duly sworn on oath, says: That I have knowledge of the facts, statements, and matters herein contained and the log of the above-described well as filed and that the same are true and correct. So help me God.

(Signature) V. M. Conover
Box 751, Great Bend, Kansas
(Address)

SUBSCRIBED AND SWORN TO before me this 3rd day of June, 1952

W. G. Smith
Notary Public.

My commission expires March 12, 1955.

PLUGGING
23-5390-s 6-51-20M
FILED SEC 17 21 R 32
BOOK PAGE 2913 26

CONSERVATION DIVISION
Wichita, Kansas

6-25-52

WELL RECORD

Company Cities Service Oil Co. Well No. 3 Farm Walters
 Location 330' South and 2310' East of Center Sec. 17 T. 21 R. 13W
 Elevation 1899 (1897 Gr.) County Stafford State Kansas
 Initial Prod. None - Dry Hole; P. & A. 6-1-52 Contractor Peak Drilling Co., Inc.
 Acid None Drlg. Comm. May 18, 1952
 T. D. 3805' Drlg. Comp. June 1, 1952

CASING RECORD:

8-5/8" @ 350' cen. 250 ex cement

FORMATION RECORD:

surface clay	0-39
lime	80
pyrite	120
shale & sand	300
lime	380
shale & red bed	800
shale & shells	1550
shale & lime	1690
lime	1915
lime & shale	2080
lime	2250
lime & shale	2375
shale & lime	2715
lime	3440
lime & shale	3453
lime	3805 T. D.

Brown Limestone	3350'
Landing	3360'
Conglomerate	3616'
Viola	3640'
Simpson	3710'
Arbuckle	3785'
Penetration	20'
Total Depth	3805'

SPERRY-SUN STRAIGHT HOLE TEST:

500'	0°
1000'	0°
1500'	0°
2000'	1°
2500'	1°
3000'	1°

D. S. T. 3427-40, open 1 hr., recovered 60' watery mud with small show of oil; B. H. P. 1020#/15 mins.

D. S. T. 3446-53, open 1 hr., recovered 90' muddy salt water; B. H. P. 1100#/15 mins.

D. S. T. 3617-64, open 30 mins., rec. 10' mud; B. H. P. 0#/15 mins.

RECEIVED
 OIL & GAS CORPORATION COMMISSION
 JUN 25 1952
 CONSERVATION DIVISION
 Wichita, Kansas

PLUGGING
 FILE SEC 17 T. 21 R. 13W
 BOOK PAGE 20 LINE 21