

WELL PLUGGING RECORD

Give All Information Completely
Make Required Affidavit
Mail or Deliver Report to:
Conservation Division
State Corporation Commission
800 Bittling Building
Wichita, Kansas

Stafford County, Sec. 17 Twp. 21 Rge. 13 (E) W (W)

Location as "NE/CNW $\frac{1}{4}$ /SW $\frac{1}{4}$ " or footage from lines SE $\frac{1}{4}$, NE $\frac{1}{4}$, NE $\frac{1}{4}$

Lease Owner Stanolind Oil and Gas Company

Lease Name G. H. Grow Well No. 3

Office Address P. O. Box 1654, Oklahoma City, Oklahoma

Character of Well (completed as Oil, Gas or Dry Hole) dry hole

Date well completed 2-28 19.53

Application for plugging filed 3-2 19.53

Application for plugging approved 3-3 19.53


Plugging commenced 3-15 19.53

Plugging completed 3-19 19.53

Reason for abandonment of well or producing formation
no commercial shows of oil or gas

If a producing well is abandoned, date of last production 19.

Was permission obtained from the Conservation Division or its agents before plugging was commenced? yes

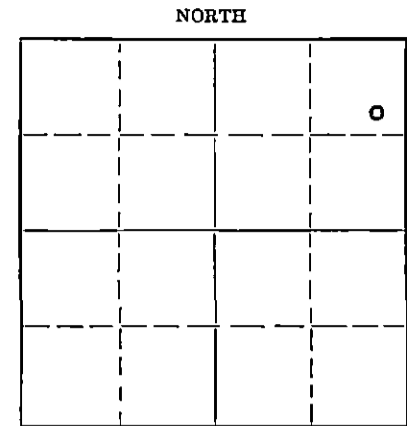

Locate well correctly on above Section Plat

Name of Conservation Agent who supervised plugging of this well M. A. Rives

Producing formation Depth to top Bottom Total Depth of Well 3709 Feet

Show depth and thickness of all water, oil and gas formations. PBD - 3512'

OIL, GAS OR WATER RECORDS

CASING RECORD

| Formation | Content | From | To | Size | Put In | Pulled Out |
|-----------|---------|------|------|-------|--------|------------|
| Arbuckle | dry | 3695 | 3709 | 8-5/8 | 793 | None |
| Lansing | dry | 3358 | 3695 | 5-1/2 | 3714 | 3251 |
| | | | | | | |
| | | | | | | |
| | | | | | | |
| | | | | | | |
| | | | | | | |
| | | | | | | |
| | | | | | | |

Describe in detail the manner in which the well was plugged, indicating where the mud fluid was placed and the method or methods used in introducing it into the hole. If cement or other plugs were used, state the character of same and depth placed, from feet to feet for each plug set.

- 3709 - TD
- 3512 - PBD
- 3512 - 3480, Rock
- 3480 - 3430, 5 sx Cement
- 3430 - 300, hvy. mud
- 300 - 290, Rock Bridge
- 290 - 230, 20 sx Cement
- 230 - 35, Hvy. Mud
- 35 - surface, Rock Bridge and 10 sx Cement

RECEIVED
STATE CORP. DIV.
3-26-53

(If additional description is necessary, use BACK of this sheet)

Name of Plugging Contractor West Supply Company

Address Chase, Kansas

STATE OF Kansas, COUNTY OF Barton, ss.

G. A. Younie (employee of owner) or (owner or operator) of the above-described well,

being first duly sworn on oath, says: That I have knowledge of the facts, statements, and matters herein contained and the log of the above-described well as filed and that the same are true and correct. So help me God.


(Signature) [Signature] Field Supt.

P. O. Box 7, Ellinwood, Kansas (Address)

SUBSCRIBED AND SWORN TO before me this 24th day of March, 19 53

[Signature] Notary Public.

My commission expires May 2, 1955

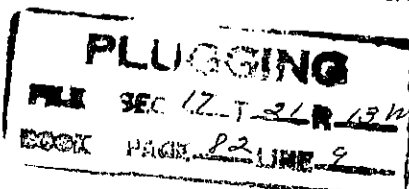

FORMATION RECORD

DESCRIBE EACH FORMATION DRILLED. INDICATE THICKNESS, CONTENT AND WHETHER DRY, OR OIL, GAS, OR WATER BEARING.

| FORMATION | TOP | BOTTOM | FORMATION | TOP | BOTTOM |
|--------------------------------------|------|--------|-----------|-----|--------|
| shale and shells | 1840 | 1840 | | | |
| shale | 1840 | 2015 | | | |
| shale and lime | 2015 | 3211 | | | |
| Top Heebner | 3211 | | | | |
| shale and lime | 3211 | 3330 | | | |
| Top Brown Lime | 3330 | | | | |
| shale and lime | 3330 | 3358 | | | |
| Top Lansing - K. C. | 3358 | | | | |
| shale and lime | 3358 | 3370 | | | |
| lime | 3370 | 3606 | | | |
| shale and lime | 3606 | 3665 | | | |
| sand | 3665 | 3668 | | | |
| shale and lime | 3668 | 3695 | | | |
| Top Arbuckle | 3695 | | | | |
| lime | 3695 | 3709 | | | |
| Schlumberger Elec. Log To TD | | | | | |
| <u>Total Depth</u> | | | | | |
| By Schlumberger | | 3699 | | | |
| By Rotary Drill | | 3700 | | | |
| well completed 3-19-53 as a dry hole | | | | | |