

15.185.11342.0000

STATE OF KANSAS
STATE CORPORATION COMMISSION


Give All Information Completely
Make Required Affidavit
Mail or Deliver Report to:
Conservation Division
State Corporation Commission
211 No. Broadway
Wichita, Kansas

WELL PLUGGING RECORD

STAFFORD County, Sec. 17 Twp. 21S Rge. 13W (X) (W)

Location as "NE/CNW/SW" or footage from lines NW SE NW
Lease Owner PETROLEUM, INC.,
Lease Name FISCHER "E" Well No. 2
Office Address ROUTE 2, GREAT BEND, KANSAS
Character of Well (completed as Oil, Gas or Dry Hole) DRY HOLE
Date well completed NOVEMBER 18 19 62
Application for plugging filed NOVEMBER 18 19 62
Application for plugging approved NOVEMBER 18 19 62
Plugging commenced NOVEMBER 18 19 62
Plugging completed NOVEMBER 18 19 62
Reason for abandonment of well or producing formation NO PRODUCING FORMATIONS
If a producing well is abandoned, date of last production NONE 19
Was permission obtained from the Conservation Division or its agents before plugging was commenced? YES

NORTH

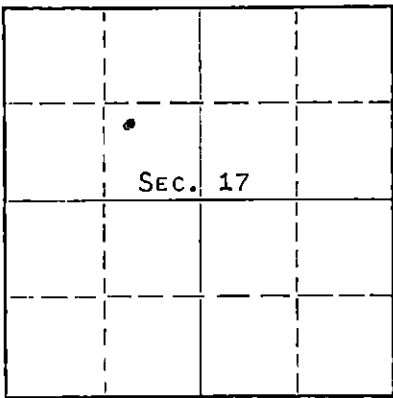

Locate well correctly on above Section Plat

Name of Conservation Agent who supervised plugging of this well W. L. LACKAMP, STAFFORD, KANSAS
Producing formation - - - - - Depth to top - - - Bottom - - - Total Depth of Well 3682 Feet
Show depth and thickness of all water, oil and gas formations.

OIL, GAS OR WATER RECORDS

CASING RECORD

FORMATION	CONTENT	FROM	TO	SIZE	PUT IN	PULLED OUT
				8-5/8"	332'	NONE

Describe in detail the manner in which the well was plugged, indicating where the mud fluid was placed and the method or methods used in introducing it into the hole. If cement or other plugs were used, state the character of same and depth placed, from feet to feet for each plug set.

MUDDED UP WITH HEAVY MUD TO 180' FOLLOWED BY WOODEN PLUG AND 1/4 SACK HULLS.
PLACED 25 SACKS CEMENT ONTO HULLS. MUDDED UP WITH HEAVY MUD TO 40' FOLLOWED
BY WOODEN PLUG, 1/4 SACK HULLS AND 10 SACKS CEMENT TO BASE OF WELL CELLAR.
PLACED 2 SACKS CEMENT IN RAT HOLE.

RECEIVED
STATE CORPORATION COMMISSION

DEC 12 1962

CONSERVATION DIVISION
Wichita, Kansas

(If additional description is necessary, use BACK of this sheet)
Name of Plugging Contractor GRAVES DRILLING CO., INC.
Address BOX 332, EL DORADO, KANSAS

STATE OF KANSAS, COUNTY OF BARTON, ss.
DON SEARLE (employee of owner) or (owner) of the above-described well, being first duly sworn on oath, says: That I have knowledge of the facts, statements and matters herein contained and the log of the above-described well as filed and that the same are true and correct. So help me God.
(Signature) DON SEARLE, DIST. PROD. SUPT.
ROUTE 2, GREAT BEND, KANSAS (Address)

SUBSCRIBED AND SWORN TO before me this 10TH day of DECEMBER, 19 62

My commission expires APRIL 14, 1963

Notary Public

R O T A R Y D R I L L E R S ' L O G

OPERATOR:	John C. Graves & Petroleum, Inc.	DRILLING COMMENCED:	November 9, 1962
CONTRACTOR:	Graves Drilling Co., Inc.	DRILLING COMPLETED:	November 18, 1962
CASING RECORD:	11 jts. 332.03' of 8-5/8" w/ 325 sx. cement	LOCATION:	Fischer "E" No. 2 NW SE NW Section 17-21S-13W Stafford County, Kansas
ELEVATION:	1916 feet, Kelly Bushing		

0 - 80	Sand, shale & lime
80 - 290	Shale & sand
290 - 330	Red bed & shale
330 - 1533	Shale
1533 - 1760	Shale & lime
1760 - 1905	Lime & shale
1905 - 2165	Lime
2165 - 2257	Shale & lime
2257 - 3010	Shale
3010 - 3075	Shale & lime
3075 - 3170	Lime & shale
3170 - 3560	Lime
3560 - 3573	Shale
3573 - 3604	Lime
3604 - 3662	Shale
3662 - 3682	Lime & Rotary Total Depth

RECEIVED
STATE CORPORATION COMMISSION
NOV 29 1962
CONSERVATION DIVISION
Wichita, Kansas

I hereby certify the foregoing statements to be true and correct to the best of my knowledge.

GRAVES DRILLING CO., INC.

By John C. Graves
President

STATE OF KANSAS)
) SS
SEDGWICK COUNTY)

Subscribed and sworn to before me, a Notary Public, this 28th day of November, 1962.

My commission expires Apr. 22, 1963

Betty Brandt
Notary Public