

WELL PLUGGING RECORD

Give All Information Completely
Make Required Affidavit
Mail or Deliver Report to:
Conservation Division
State Corporation Commission
800 Biting Building
Wichita, Kansas

NE-SE-SE County. Sec. 17 Twp. 21 Rge. 13 ~~NE~~ W (W)

Location as "NE/CNW&SW" or footage from lines S/2 of SE/4

Lease Owner PETROLEUM, Inc.

Lease Name VINK Well No. 1

Office Address 311 East Third Street, Wichita, Kansas

Character of Well (completed as Oil, Gas or Dry Hole) Oil

Date well completed July 28 1952

Application for plugging filed February 9 1955

Application for plugging approved February 15 1955

Plugging commenced March 1 1955


Plugging completed March 9 1955

Reason for abandonment of well or producing formation _____

Depletion of producible zones

If a producing well is abandoned, date of last production February 7 1955

Was permission obtained from the Conservation Division or its agents before plugging was commenced? Yes

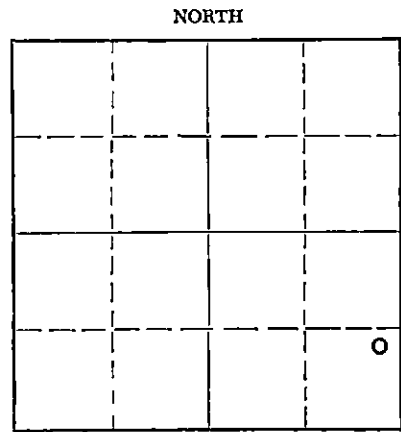

Locate well correctly on above Section Plat

Name of Conservation Agent who supervised plugging of this well M.A. Rives, Pratt, Kansas

Producing formation Arbuckle Depth to top 3,660' Bottom 3,718' Total Depth of Well 3,718' Feet

Show depth and thickness of all water, oil and gas formations.

OIL, GAS OR WATER RECORDS

CASING RECORD

FORMATION	CONTENT	FROM	TO	SIZE	PUT IN	PULLED OUT
Arbuckle	Oil & Water	3,664'	3,668'	8-5/8"	295'	NONE
Arbuckle	Oil & Water	3,680'	3,684'	5-1/2"	3,717'	2,970'

Describe in detail the manner in which the well was plugged, indicating where the mud fluid was placed and the method or methods used in introducing it into the hole. If cement or other plugs were used, state the character of same and depth placed, from _____ feet to _____ feet for each plug set.

(Drilled out to 3,707')

Filled hole with crushed rock from 3,707' to 3,650', and placed 5 sacks cement from 3,650' to 3,615'. Filled hole with heavy mud from 3,615' to 275'. Placed rock bridge at 275'. Run 20 sacks cement from 275' to 235' and filled hole with heavy mud from 235' to 35', and placed solid rock bridge at 35'. Filled hole with 10 sacks cement to base of well cellar.

3-23-55

CONSERVATION DIVISION
WICHITA, KANSAS

(If additional description is necessary, use BACK of this sheet)

Name of Plugging Contractor Morgan Well Plugging Service (License #43)

Address 102 West 8th Street, Hutchinson, Kansas

STATE OF Kansas, COUNTY OF Barton, ss.
Paul B. Shivel (employee of owner) or (owner or operator) of the above-described

well, being first duly sworn on oath, says: That I have knowledge of the facts, statements, and matters herein contained and the log of the above-described well as filed and that the same are true and correct. So help me God.


(Signature) Paul B. Shivel

Route 2, Great Bend, Kansas
(Address)

SUBSCRIBED AND SWORN to before me this 18th day of March, 1955

Goy B. Anderson
Notary Public.

My commission expires November 21, 1957

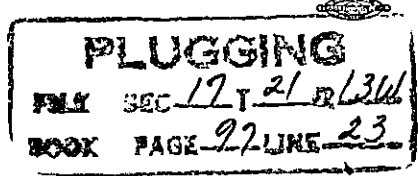

DRILLER'S LOG VINK #1

Petroleum, Inc., Lease Owner

Section 17, Twp. 21S, Rge. 13W

Garvey Drilling Company, Contractor

Location: NE SE SE

Drilling Commenced: July 13, 1952

County: Stafford County, Kansas

Drilling Completed: July 23, 1952

R.T.D. 3718'

Casing Records: 8 5/8" @ 295' w/175 sax
5 1/2" 3717' w/75 sax

Production: Arbuckle

Figures below indicate bottom of formation:

55 Sand
 80 Hard Sand
 220 Shale
 290 Sand & Gravel
 295 Shale
 535 Shale & Shells
 788 Red Bed
 811 Anhydrite
 1450 Shale & Shells
 2590 Lime & Shale
 2675 Shale & Shells
 3145 Lime & Shale
 3195 Lime
 3269 Lime & Shale
 3613 Lime
 3625 Chert
 3672 Shale
 3718 Lime
 3718' R.T.D.

Tops:

Heebner: 3219 (-1317)
 Brown Lime: 3343 (-1441)
 Lansing: 3354 (-1452)
 Arbuckle: 3660 (-1758)

DST #1, 3386-3432, open 45 mins., rec. 20' mud, 0# BHP
 DST #2, 3592-3596, open 1/2 hr., rec. 8' mud, 175# BHP.
 DST #3, 3669-72, open 40 mins., rec. 5' mud, 0# BHP.
 DST #4, 3672-82, open 1 hr., rec. 120' very heavily oil cut mud, 60' muddy oil, 235' free oil, 1150# BHP.

I hereby certify that this is a true and correct log of the above mentioned well.

PETROLEUM, INC.

By W. W. Fisher

STATE OF KANSAS)
COUNTY OF SEDGWICK)

PLUGGING
 SS FILE SEC 17 T 21 R 13 W
 BOOK PAGE 27 LINE 23

RECEIVED
 COMMISSION
 MAR 23 1955
 DIVISION

Subscribed to and sworn to before me, a Notary Public, in said County and State, this 2nd day of August, 1952.

My commission expires: October 13, 1954.

Charlotte Weaver
 Notary Public