


STATE OF KANSAS
STATE CORPORATION COMMISSION

WELL PLUGGING RECORD

Give All Information Completely
Make Required Affidavit
Mail or Deliver Report to:
Conservation Division
State Corporation Commission
211 No. Broadway
Wichita, Kansas

McPherson County. Sec. 14 Twp. 21 Rge. XXX (E) 4 (W)
Location as "NE/CNW/SW" or footage from lines SE SE NE NW

Lease Owner Burch Exploration LTD
Lease Name Buller Well No. 1
Office Address 1011 Union Center, Wichita, Kansas
Character of Well (completed as Oil, Gas or Dry Hole) dry hole
Date well completed 11-5-64 19
Application for plugging filed 11-13-64 19
Application for plugging approved 19
Plugging commenced 3:00 a.m. 11-5-64 19
Plugging completed 5:00 a.m. 11-5-64 19
Reason for abandonment of well or producing formation dry hole

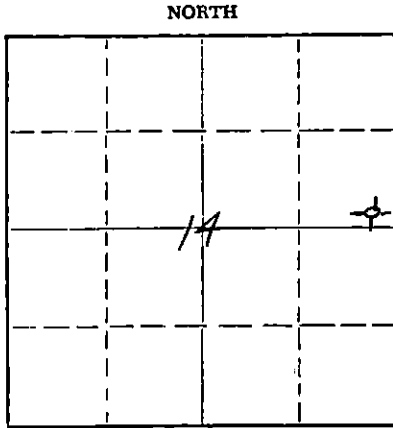

Locate well correctly on above
Section Plat

If a producing well is abandoned, date of last production 19
Was permission obtained from the Conservation Division or its agents before plugging was commenced? yes

Name of Conservation Agent who supervised plugging of this well Gilbert Toman
Producing formation _____ Depth to top _____ Bottom _____ Total Depth of Well _____ Feet
Show depth and thickness of all water, oil and gas formations.

OIL, GAS OR WATER RECORDS

CASING RECORD

FORMATION	CONTENT	FROM	TO	SIZE	PUT IN	PULLED OUT
		0'	580'	8 5/8"	580'	none

Describe in detail the manner in which the well was plugged, indicating where the mud fluid was placed and the method or methods used in introducing it into the hole. If cement or other plugs were used, state the character of same and depth placed, from _____ feet to _____ feet for each plug set.

Bottom plug @ 200' with 1/4 sack hulls and 25 sx cement.
Top Plug @ 40' with 1/2 sack hulls and 10 sx cement.
x 2 sacks cement in rat hole.

RECEIVED
STATE CORPORATION COMMISSION

11-16-64 NOV 16 1964

CONSERVATION DIVISION
Wichita, Kansas

(If additional description is necessary, use BACK of this sheet)

Name of Plugging Contractor Vaughan Drilling, Inc.
Address Box 825, Great Bend, Kansas

STATE OF KANSAS, COUNTY OF BARTON, ss.
Donald D. Vaughan (employee of owner) or (owner or operator) of the above-described well, being first duly sworn on oath, says: That I have knowledge of the facts, statements, and matters herein contained and the log of the above-described well as filed and that the same are true and correct. So help me God.

(Signature) Donald D. Vaughan
Vaughan Drilling, Inc. by Donald D. Vaughan
Box 825, Great Bend, Kansas
(Address)

SUBSCRIBED AND SWORN TO before me this 13th day of November, 19 64

My commission expires Jan. 24, 1968

Dorothy Tully
Dorothy Tully Notary Public.

WELL LOG

COMPANY Burch Exploration, LTD.
 CONTRACTOR Vaughan Drilling, Inc.
 FARM Buller #1
 LOCATION SE SE NW ~~30-30-30~~ of sec. 14-21-4W, McPherson County, Kansas
 ELEVATION 1450' K. B.
 SURFACE PIPE 580' of 8/ 5/8" surface pipe cemented with 375 sx. posmix.
 PRODUCTION D & A
 COMMENCED 10-23-64
 COMPLETED 11-5-64

<u>FORMATION</u>	<u>DEPTH</u>
Clay	65
Sandstone	140
Shale	400
Salt & Shale	560
Shells	580
Anhydrite	620
Limestone	635
Limestone & Shale	960
Limestone	1306
Limestone & Shale	2245
Limestone	2345
Shale & Sandstone	2490
Shale	2610
Limestone & Shale	2620
Limestone	3147
Shale	3190
Conglomerate	3280
Mississippi	3590
Shale (Kinderhook)	3653
Shale	3892
Simpson	3911
Rotary Total Depth	3913

RECEIVED
STATE CORPORATION COMMISSION

NOV 16 1964

CONSERVATION DIVISION
Wichita, Kansas


FORMATION TOPS

Heebner	2331 (- 881)
Toronto	2350 (- 900)
Douglas Sand	2364 (- 914)
Brn. Lime	2527 (-1077)
Lansing	2574 (-1124)
Base Kansas City	3084 (-1634)
Conglomerate	3149 (-1699)
Mississippi	3262 (-1812)
Misner	3713 (-2263)
Hunton	3738 (-2288)
Maquoketa	3734 (-2293)
Viola	3799 (-2349)
Simpson Shale	3831 (-2381)
Simpson Sand	3834 (-2384)
Arbuckle	3904 (-2454)
RTD	3913 (-2463)

A F F I D A V I T

STATE OF KANSAS, COUNTY OF BARTON, SS:

I, Donald D. Vaughan, of the Vaughan Drilling, In., being first duly sworn on oath, state; that I have knowledge of the facts, statements and matters herein contained and that the same are true and correct.

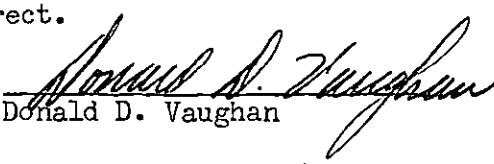
Donald D. Vaughan

Subscribed and sworn to before me this 11th day of November, 1964.


Dorothy Tully, Notary Public.

My commission expires: Jan. 24, 1968.