


STATE OF KANSAS
STATE CORPORATION COMMISSION

Give All Information Completely
Make Required Affidavit
Mail or Deliver Report to:
Conservation Division
State Corporation Commission
211 No. Broadway
Wichita, Kansas

WELL PLUGGING RECORD

NORTH

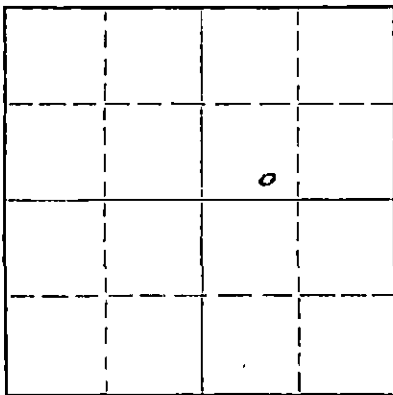

Locate well correctly on above
Section Plat

Kiowa County. Sec. 12 Twp. 28S Rge. 18 (W)
Location as "NE/CNW/SW" or footage from lines C, SE SW NE/4
Lease Owner E. K. Carey Drilling Co., Inc.
Lease Name Chas. Einsel Unit Well No. 1
Office Address Box 620, McPherson, Kansas
Character of Well (completed as Oil, Gas or Dry Hole) Dry hole
Date well completed August 12, 19 57
Application for plugging filed August 12, 19 57
Application for plugging approved August 12, 19 57
Plugging commenced 7:30 P.M. August 12, 19 57
Plugging completed 10:30 P.M. August 12, 19 57
Reason for abandonment of well or producing formation Dry hole non-productive

If a producing well is abandoned, date of last production _____ 19 ____
Was permission obtained from the Conservation Division or its agents before plugging was commenced? Yes

Name of Conservation Agent who supervised plugging of this well M. A. Rives, Pratt, Kansas
Producing formation _____ Depth to top _____ Bottom _____ Total Depth of Well 4960 Feet
Show depth and thickness of all water, oil and gas formations.

OIL, GAS OR WATER RECORDS

CASING RECORD

FORMATION	CONTENT	FROM	TO	SIZE	PUT IN	PULLED OUT
				8-5/8	320'	None

Describe in detail the manner in which the well was plugged, indicating where the mud fluid was placed and the method or methods used in introducing it into the hole. If cement or other plugs were used, state the character of same and depth placed, from _____ feet to _____ feet for each plug set.

Gunned pits and circulated heavy mud on bottom and half way out. Laid down all but 10 joints drill pipe. Finished filling hole with in 300' of top with heavy mud. Set bridge and plug here that would hold weight of 10 joints drill pipe and had Halliburton displace 20 sacks cement through drill pipe on top this bridge plug at 320', then filled with mud to 35' of cellar floor. Placed Halliburton wood plug on top of mud at 35' and 1/2 sack cotton seed hulls on top of plug and 10 sacks cement to cellar floor.

(If additional description is necessary, use BACK of this sheet)

Name of Plugging Contractor Lewis Drilling Company, Rotary Tools
Address 915 Union Center Bldg., Wichita, Kansas

STATE OF Kansas, COUNTY OF McPherson, ss.
Herbert Rhoton, Superintendent (employee of owner) or (owner or operator) of the above-described

well, being first duly sworn on oath, says: That I have knowledge of the facts, statements, and matters herein contained and the log of the above-described well as filed and that the same are true and correct. So help me God.

(Signature) Herbert Rhoton

Box 620, McPherson, Kansas
(Address)

SUBSCRIBED AND SWORN TO before me this 13th day of August, 19 57

My commission expires November 13, 1960

RECEIVED
STATE CORPORATION COMMISSION

PLUGGING
FILE SEC. 12 T. 28 R. 18W
BOOK PAGE 37 LINE 27

8-19-57

AUG 19 1957

CONSERVATION DIVISION
Wichita, Kansas


WELL LOG

COMPANY E. K. Carey Drilling Co., Inc.
 FARM Einsel NO. 1

12 28 101
 SEC. SE 1/4 T. 12 N. R. 28 E.
 LOG.

TOTAL DEPTH 4960
 COMM. 7-26-57 COMP. 8-12-57
 SHOT OR TREATED
 CONTRACTOR Lewis Drilling Company
 ISSUED

COUNTY Flowa
 KANSAS

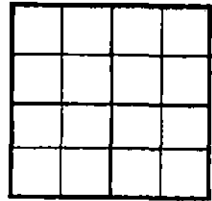

ELEVATION 2193 K.L.B.

PRODUCTION

CASING

20 10 8 5/8 - 320'
 15 8
 12 6
 13 5

FIGURES INDICATE BOTTOM OF FORMATIONS

0-230
 230-319
 319-1560
 1560-2535
 2535-4191
 4191-4815
 4815-4855
 4855-4879
 4879-4960
 4960

Sand & gravel
 Blue shale
 Red beds & shale
 Shale
 Shale & lime
 Lime
 Lime & shale
 Shale & sand
 Lime
 T.D.

Geologic Tops

Heshmor	1005
Douglas	1052
Brown Lim	1165
Lansing MC	1279
B/Kansas City	1572
Marmston	1531
Mississippian	1708
Kinderhook	1801
Viola	1901

State of Kansas
 County of Sedgwick SS:

PLUGGING

FILE SEC. 12 T. 28 R. 18W
 BOOK PAGE 37 LINE 27

RECEIVED
 STATE COMMISSIONER OF GEOLOGY

AUG 19 1957

GEOLOGICAL DIVISION
 TOPEKA, KANSAS

I, J. Fred Hambricht of the Lewis Drilling Company

upon oath state that the above and foregoing is a true and correct copy of the log of the Einsel #1 well.

Subscribed and sworn to before me this 16 day of August 19 57

My Commission Expires: 6-20-60

A. R. Derrington
 A. R. Derrington NOTARY PUBLIC