


STATE OF KANSAS
STATE CORPORATION COMMISSION

Give All Information Completely
Make Required Affidavit
Mail or Deliver Report to:
Conservation Division
State Corporation Commission
800 Biting Building
Wichita, Kansas

WELL PLUGGING RECORD

NORTH

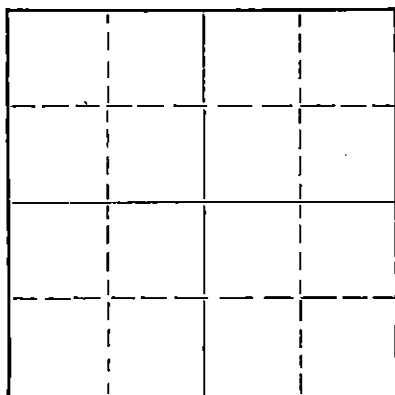

Locate well correctly on above
Section Plat

Kiowa County. Sec. 35 Twp. 28 Rge. 18 (E) (W)
Location as "NE/CNW&SW" or footage from lines NW NW NW
Lease Owner Trans Era Petroleum, Inc.
Lease Name Ahrens Well No. 1
Office Address Russell, Kansas
Character of Well (completed as Oil, Gas or Dry Hole) Dry Hole
Date well completed 5/3/55 19
Application for plugging filed 5/2/55 19
Application for plugging approved 5/2/55 19
Plugging commenced 5/3/55 19
Plugging completed 5/3/55 19
Reason for abandonment of well or producing formation Dry Hole

If a producing well is abandoned, date of last production _____ 19____
Was permission obtained from the Conservation Division or its agents before plugging was commenced? Yes

Name of Conservation Agent who supervised plugging of this well M. A. Rives
Producing formation _____ Depth to top _____ Bottom _____ Total Depth of Well 5349 Feet
Show depth and thickness of all water, oil and gas formations.

OIL, GAS OR WATER RECORDS

CASING RECORD

FORMATION	CONTENT	FROM	TO	SIZE	PUT IN	PULLED OUT
				8 5/8"	390	none

Describe in detail the manner in which the well was plugged, indicating where the mud fluid was placed and the method or methods used in introducing it into the hole. If cement or other plugs were used, state the character of same and depth placed, from _____ feet to _____ feet for each plug set.

PLUGGING RECORD

set first wooden plug. Used
Filled hole with heavy mud to 350' and 1/4 sack hulls, & 20 sacks cement.
filled with mud to 35' and set 2nd plug using 1/4 sacks hulls and 10
sacks cement.

(If additional description is necessary, use BACK of this sheet)
Name of Plugging Contractor Trans Era Petroleum, Inc.
Address Box 633, Russell, Kansas

STATE OF KANSAS, COUNTY OF RUSSELL, ss.
H. R. Michaelis (employee of owner) or (owner or operator) of the above-described well, being first duly sworn on oath, says: That I have knowledge of the facts, statements, and matters herein contained and the log of the above-described well as filed and that the same are true and correct. So help me God.

(Signature) H. R. Michaelis

(Address)

SUBSCRIBED AND SWORN TO before me this 19th day of May, 19 55

Margie Cooper
Notary Public.

My commission expires 1-30-57

PLUGGING
FILE SEC 35 T 28 R 18W
BOOK PAGE 44 LINE 39

MAY 21 1955
5-21-55
CONSERVATION DIVISION
Wichita, Kansas

Trans Era Petroleum, Inc.
 AHRENS #1

NW NW NW 35-28-18
 Kiowa County, Kansas

Total Depth: 5349

Comm: 4/9/55
 Comp: 5/3/55

Casing:

8 5/8" @ 390'

Cement:

275 sacks of Monarch

FORMATION	DEPTH
Surface Soil & Clay	75
Sand	185
Sand	220
Shale & Shells	390
Sand & Red Bed	560
Red Bed	975
Red Bed & Shale	1165
Salt	1690
Shale	2020
Shale & Lime	2295
Lime	2800
Shale & Lime	4023
Lime	4775
Lime & Shale	4854
Lime	4915
Chert	4940
Lime	4950
Lime & Chert	4972
Lime	4990
Lime & Sand	5018
Lime	5085
Lime & Chert	5113
Lime	5349

STATE OF KANSAS)
)) ss:
 COUNTY OF RUSSELL)

I hereby certify that the above information is true and correct to the best of my knowledge.

SR Michaels

Subscribed and sworn to before me this 19th day of May, 1955.

Margie Cooper

 Notary Public

My commission expires 1-30-57.

PLUGGING
 FILE SEC 35-28-18W
 BOOK PAGE 116 LINE 39

RECEIVED
 STATE CORPORATION
 MAY 21 1955
 CONSERVATION DIVISION
 Wichita, Kansas