


STATE OF KANSAS
STATE CORPORATION COMMISSION

Form CP-4

Give All Information Completely
Make Required Affidavit
Mail or Deliver Report to:
Conservation Division
State Corporation Commission
P. O. Box 17027
Wichita, Kansas 67217
NORTH

WELL PLUGGING RECORD

Location as "NE/CNW/SW" or footage from lines KIOWA County. Sec. 4 Twp. 18 Rge. 19W (E) (W)
Lease Owner PICKRELL DRILLING COMPANY
Lease Name Crowell "A" Well No. #1
Office Address 705 Fourth Nat'l Bank Bldg.
Character of Well (completed as Oil, Gas or Dry Hole) Dry Hole
Date well completed 12-20 19 74
Application for plugging filed 12-20 19 74
Application for plugging approved 12-20 19 74
Plugging commenced 12-20 19 74
Plugging completed 12-20 19 74
Reason for abandonment of well or producing formation Dry Hole

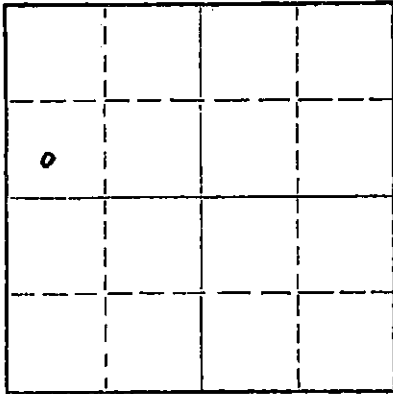

Locate well correctly on above Section Plat

If a producing well is abandoned, date of last production 19
Was permission obtained from the Conservation Division or its agents before plugging was commenced? Yes

Name of Conservation Agent who supervised plugging of this well Eugene Graham
Producing formation _____ Depth to top _____ Bottom _____ Total Depth of Well 4911 Feet
Show depth and thickness of all water, oil and gas formations.

OIL, GAS OR WATER RECORDS

CASING RECORD

FORMATION	CONTENT	FROM	TO	SIZE	PUT IN	PULLED OUT
				8 5/8"	279'	None

Describe in detail the manner in which the well was plugged, indicating where the mud fluid was placed and the method or methods used in introducing it into the hole. If cement or other plugs were used, state the character of same and depth placed, from _____ feet to _____ feet for each plug set.

35 sacks at 270'

15 sacks at 40' with bridge plug

2 sacks in rat hole. Job completed at 10 AM 12-20-74

RECEIVED
STATE CORPORATION COMMISSION
JAN 2 1974
CONSERVATION DIVISION
Wichita, Kansas
1-2-74

(If additional description is necessary, use BACK of this sheet)

Name of Plugging Contractor PICKRELL DRILLING COMPANY
Address 705 4th Nat'l Bank Bldg. Wichita, Ks. 67202

STATE OF Kansas, COUNTY OF Sedgwick, ss.
C.W. Sebitts (employee of owner) or (owner or operator) of the above-described well, being first duly sworn on oath, says: That I have knowledge of the facts, statements and matters herein contained and the log of the above-described well as filed and that the same are true and correct. So help me God.

(Signature) C.W. Sebitts
705 4th Nat'l Bank Bldg. Wichita, Ks.
(Address)

SUBSCRIBED AND SWORN TO before me this 31 day of December, 19 74

My commission expires August 19, 1975

Helen L. Martin
Helen L. Martin
Notary Public.

ROTARY DRILLING LOG

15-097-20270-0000

COMPANY: PICKRELL DRILLING COMPANY
 705 Fourth Nat'l Bank Bldg.
 Wichita, Ks. 67202

LOCATION: Crowell "A" #1
 SW NW 4-28S-19W
 Kiowa County, Ks.

CONTRACTOR: PICKRELL DRILLING COMPANY
 Wichita, Kansas

Rotary Drilling Commenced 12-7-74

Rotary Drilling Completed 12-20-74

CASING RECORD: (5 joints) 8 5/8" casing set at 279' and cemented with 225 sacks cement.
 Job completed 12-8-74 @ 12:30 A.M.

LOG

(Figures indicate bottom of formation — measurements from top of rotary bushing.)

115	Sand	
230	Sandy Clay	
349	Shale	
907	Shale-Sand-Red Beds	
1218	Shale & Shells	
1248	Anhy	
1781	Shale & Shells	
2125	Shale & Shells	
2308	Shale & Lime Stks.	
2433'	Lime & Shale	4310'
2605	Lime & Shale	4450'
2705	Lime & Shale	4635'
2850	Lime & Shale	4820'
2960	Lime & Shale	4836'
3050	Lime & Shale	4840'
3244	Lime & Shale	4847'
3337	Lime & Shale	4891'
3475	Lime & Shale	4911'
3600	Lime & Shale	
3700	Lime & Shale	
3795	Lime & Shale	
4015	Lime & Shale	
4135	Lime & Shale	
4260	Lime	
4365	Lime	
4405	Lime	
4470	Lime	
4545	Lime	
4610	Lime	
4670	Lime & Chert	
4725	Lime	
4776	Lime	
4835	Lime	
4880	Lime	
4891	Miss.	
4911	Miss	

RECEIVED 12-30-74
 STATE CORPORATION COMMISSION
 DEC 30 1974
 CONSERVATION DIVISION
 Wichita, Kansas

C.F.S

The undersigned, C.W. Sebitts, Attorney-in-Fact for PICKRELL DRILLING COMPANY, hereby certifies in behalf of said Company, that the above is a true and correct log of the formation encountered in drilling the above well as reflected by the Daily Drilling Reports.

PICKRELL DRILLING COMPANY


 By C.W. Sebitts Attorney-in-Fact

STATE OF KANSAS }
 COUNTY OF SEDGWICK } ss.:

On this 27 day of December, 19 74, before me the undersigned, a Notary Public, in and for the County and State aforesaid, personally appeared C.W. Sebitts, to me known to be the identical person who subscribed the name of PICKRELL DRILLING COMPANY to the foregoing instrument as its Attorney-in-Fact and acknowledged to me that he executed the same as his free and voluntary act and deed, and as the free and voluntary act and deed of such company, for the uses and purposes therein set forth.

Given under my hand and seal of office the day and year last above written.

My commission expires: August 19, 1975


 Helen L. Martin Notary Public