


STATE OF KANSAS
STATE CORPORATION COMMISSION

Form CP-4

Give All Information Completely
Make Required Affidavit
Mail or Deliver Report to:
Conservation Division
State Corporation Commission
P. O. Box 17027
Wichita, Kansas 67217
NORTH

WELL PLUGGING RECORD

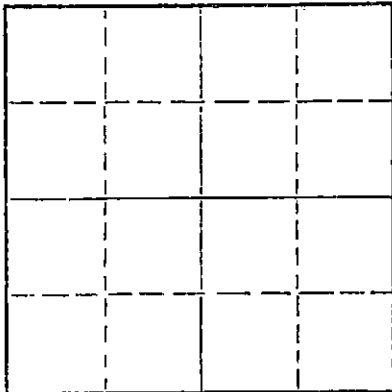

Locate well correctly on above
Section Plat

Rice County, Sec. 5 Twp. 21 Rge. (E) 6 (W)
Location as "NE/CNW/SE/SW" or footage from lines SE-NE-SW
Lease Owner North Ridge Oil Co.
Lease Name Engeland Well No. 1-A
Office Address Box 18271 Denver, Colo.
Character of Well (completed as Oil, Gas or Dry Hole) Oil
Date well completed 19
Application for plugging filed 19
Application for plugging approved 19
Plugging commenced 8-14-1972
Plugging completed 8-22-1972
Reason for abandonment of well or producing formation

If a producing well is abandoned, date of last production 19
Was permission obtained from the Conservation Division or its agents before plugging was commenced? Yes

Name of Conservation Agent who supervised plugging of this well Gilbert Toman
Producing formation Depth to top Bottom Total Depth of Well 3461 Feet
Show depth and thickness of all water, oil and gas formations.

OIL, GAS OR WATER RECORDS

CASING RECORD

FORMATION	CONTENT	FROM	TO	SIZE	PUT IN	PULLED OUT
				10 1/2"	178	None
				7"	3457	1320

Describe in detail the manner in which the well was plugged, indicating where the mud fluid was placed and the method or methods used in introducing it into the hole. If cement or other plugs were used, state the character of same and depth placed, from feet to feet for each plug set.

Sand back to 3440 ft.- dump 6 sax cement - pull 1320 ft. 7" pipe.
Allied Cementing Co. pumped 3 sax hulls, 25 sax gel & 100 sax cement.

RECEIVED
STATE CORPORATION COMMISSION

SEP 5 1972 7-5-72

CONSERVATION DIVISION
Wichita, Kansas

(If additional description is necessary, use BACK of this sheet)
Name of Plugging Contractor Ralph Comstock Pipe Pulling, Inc. Permit # 490
Address 320 N. Park Stafford, Kansas 67578

STATE OF Colorado, COUNTY OF Denver, ss.
George E. White, Pres. (employee of owner) or (owner or operator) of the above-described well, being first duly sworn on oath, says: That I have knowledge of the facts, statements, and matters herein contained and the log of the above-described well as filed and that the same are true and correct. So help me God. NORTH RIDGE OIL COMPANY

(Signature) [Signature] P O BOX 18271-Denver, Colo. 80218
(Address)

SUBSCRIBED AND SWORN to before me this 31st day of August, 1972

My commission expires March 13, 1973

[Signature] Ethel M. Morris Notary Public.

300 East Wichita
Wichita, Kansas

NOV 29 1969

15.159.20245.0000

TRIANGLE DRILLING

324 North Orchard
EL DORADO, KANSAS

#1 Engellwood
COPY
5-21-6W
SE NE SW

To Commercial Oil Co.

Invoice No. _____

5252 N. Broadway

Date September 19, 1969

Wichita, Kansas

For Month Of _____

Lease Engellwood 5-21-6W Rice County, Kansas *oil*

WELL LOG

0	-----	3	Soil
3	-----	178	Sand
178	-----	210	Sandy Shale
210	-----	860	Sand and Shale
860	-----	1025	Shale
1025	-----	1411	Lime and Shale
1411	-----	2531	Lime and Shale
2531	-----	2610	Lime
2610	-----	2712	Lime and Shale
2712	-----	2850	Shale
2850	-----	3430	Lime and Shale
3430	-----	3457	Conglomerate
3457	-----	3461	Miss. R.T.D.

RECEIVED
STATE CORPORATION COMMISSION

AUG 15 1972

CONSERVATION DIVISION
Wichita, Kansas

TRIANGLE DRILLING

15.159.20245.0000

324 North Orchard
EL DORADO, KANSAS

To Commercial Oil Co.

Invoice No. _____

5252 N. Broadway

Date September 19, 1969

Wichita, Kansas

For Month Of _____

Lease ~~England~~ Rice County Kansas

WELL LOG

CE/2 E/2 SW/4 Sec. 5-21 S-6 W

0	-----	3	Soil
3	-----	178	Sand
178	-----	210	Sandy Shale
210	-----	860	Sand and Shale
860	-----	1025	Shale
1025	-----	1411	Lime and Shale
1411	-----	2531	Lime and Shale
2531	-----	2610	Lime
2610	-----	2712	Lime and Shale
2712	-----	2850	Shale
2850	-----	3430	Lime and Shale
3430	-----	3457	Conglomerate
3457	-----	3461	Miss. R.T.D.

RECEIVED
STATE CORPORATION COMMISSION
AUG 14 1972
CONSERVATION DIVISION
Wichita, Kansas

*10 3/4 @ 178' 100 Sack
7" @ 3457' 80 sacks cement*

Only log Available