

TYPE

AFFIDAVIT OF COMPLETION FORM

ACO-1 WELL HISTORY

Compt. \_\_\_\_\_

SIDE ONE

Two (2) copies of this form shall be filed with the Kansas Corporation Commission, 200 Colorado Derby Building, Wichita, Kansas 67202, within thirty (30) days after the completion of a well, regardless of how the well was completed.

(D)  Attach separate letter of request if the information is to be held confidential. If confidential, only file one copy. Information on Side One will be of public record and Side Two will then be held confidential.

Applications must be made on dual completion, commingling, salt water disposal, injection and temporarily abandoned wells.

(C)  Attach one copy only wireline logs (i.e. electrical log, sonic log, gamma ray neutron log, etc.). (Rules 82-2-105 & 82-2-125) KCC# (316) 263-3238.

LICENSE # 5339 EXPIRATION DATE 6-30-84

OPERATOR Bergman Oil Company API NO. 15-185-21,807

ADDRESS 520 Union Center COUNTY Stafford

Wichita, Kansas 67202 FIELD Sand Hills

\*\* CONTACT PERSON Harold I. Bergman PROD. FORMATION Arbuckle

PHONE 316-267-5291

PURCHASER Getty Crude Gathering, Inc. LEASE Mellies

ADDRESS P.O. Box 3000 WELL NO. 4

Tulsa, OK 74102 WELL LOCATION N/2 N/2 NE


DRILLING CONTRACTOR Rains & Williamson Oil Co., Inc. 330' Ft. from North Line and

ADDRESS 435 Page Court, 220 W. Douglas 1320' Ft. from East Line of (X)  
Wichita, Kansas 67202 the NE (Qtr.) SEC 36 TWP 21S RGE 12 (W).

PLUGGING CONTRACTOR \_\_\_\_\_

ADDRESS \_\_\_\_\_

WELL PLAT

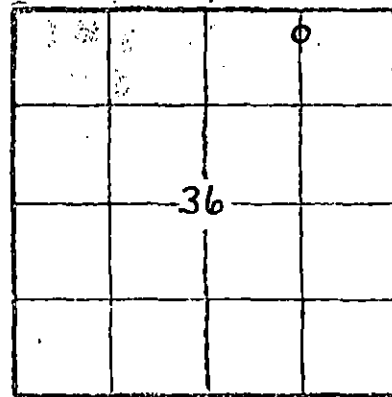

(Office Use Only)

KCC   
KGS

SWD/REP \_\_\_\_\_  
PLG. \_\_\_\_\_

TOTAL DEPTH 3572' PBTD \_\_\_\_\_

SPUD DATE 6-8-83 DATE COMPLETED 7-11-83

ELEV: GR 1788 DF \_\_\_\_\_ KB 1797

DRILLED WITH (CABLE) (ROTARY) (AIR) TOOLS.

DOCKET NO. OF DISPOSAL OR REPRESSURING WELL BEING USED TO DISPOSE OF WATER FROM THIS LEASE \_\_\_\_\_

Amount of surface pipe set and cemented 261' DV Tool Used? \_\_\_\_\_

THIS AFFIDAVIT APPLIES TO: (Circle ONE) - Oil, Gas, Shut-in Gas, Dry, Disposal, Injection, Temporarily Abandoned, OWWO. Other \_\_\_\_\_

ALL REQUIREMENTS OF THE STATUTES, RULES AND REGULATIONS PROMULGATED TO REGULATE THE OIL AND GAS INDUSTRY HAVE BEEN FULLY COMPLIED WITH.

AUG 10 1983

A F F I D A V I T

Harold I. Bergman, being of lawful age, hereby certifies that:

I am the Affiant, and I am familiar with the contents of the foregoing Affidavit. The statements and allegations contained therein are true and correct.

*Harold I. Bergman*  
(Name)

SUBSCRIBED AND SWORN TO BEFORE ME this 10th day of August, 1983

*Alma A. Neises*  
(NOTARY PUBLIC)  
Alma A. Neises

MY COMMISSION EXPIRES: May 31, 1986

\*\* The person who can be reached by phone regarding any questions concerning this information.

CONFIDENTIAL