


STATE OF KANSAS
STATE CORPORATION COMMISSION

Form CP-4

WELL PLUGGING RECORD

Give All Information Completely
Make Required Affidavit
Mail or Deliver Report to:
Conservation Division
State Corporation Commission
P. O. Box 17027
Wichita, Kansas 67217

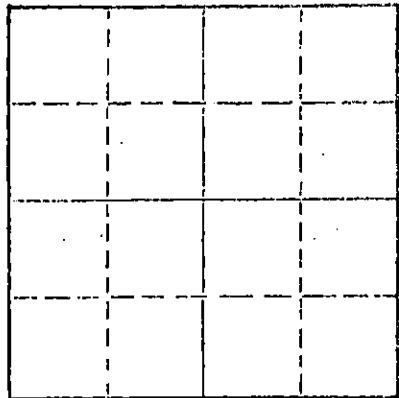

Locate well correctly on above
Section Plat

Kiowa County, Sec. 2 Twp 30S Rgo. 18 (X) X (W)
Location as "NE/CNW/ESW" or footage from lines 150' NW of C SW SW
Lease Owner Rains & Williamson Oil Co., Inc.
Lease Name Fincham Well No. 1
Office Address 435 Page Court, 220 W. Douglas, Wichita, Ks.
Character of Well (completed as Oil, Gas or Dry Hole) Dry Hole
Date well completed 3-23-74 19
Application for plugging filed 3-22-74 19
Application for plugging approved 3-22-74 19
Plugging commenced 3-22-74 19
Plugging completed 3-23-74 19
Reason for abandonment of well or producing formation commercial quantities of oil not found.
If a producing well is abandoned, date of last production 19
Was permission obtained from the Conservation Division or its agents before plugging was commenced? yes

Name of Conservation Agent who supervised plugging of this well G. R. Biberstein
Producing formation _____ Depth to top _____ Bottom _____ Total Depth of Well 3675' Feet
Show depth and thickness of all water, oil and gas formations.

OIL, GAS OR WATER RECORDS

CASING RECORD

FORMATION	CONTENT	FROM	TO	SIZE	PUT IN	PULLED OUT
				8-5/8"	406'	

Describe in detail the manner in which the well was plugged, indicating where the mud fluid was placed and the method or methods used in introducing it into the hole. If cement or other plugs were used, state the character of same and depth placed, from _____ feet to _____ feet for each plug set.

Plugged with 40 sx. @ 300'
13 sx. @ 40'
2 sx. rathole

RECEIVED
STATE CORPORATION COMMISSION
MAR 29 1974
CONSERVATION DIVISION
Wichita, Kansas

(If additional description is necessary, use BACK of this sheet)
Name of Plugging Contractor Rains & Williamson Oil Co., Inc.
Address 435 Page Court, 220 W. Douglas, Wichita, Kansas 67202

STATE OF KANSAS COUNTY OF SEDGWICK, ss.
Wilson Rains (employee of owner) or (owner or operator) of the above-described well, being first duly sworn on oath, says: That I have knowledge of the facts, statements, and matters herein contained and the log of the above-described well as filed and that the same are true and correct. So help me God.

(Signature) Wilson Rains
435 Page Ct., 220 W. Douglas, Wichita, Ks.
(Address)

Subscribed and sworn to before me this 25th day of March 19 74
Juanita M. Green
Notary Public.
My commission expires October 4, 1975



WELL LOG 15.097.20219.00.00

COMPANY Rains & Williamson Oil Co., Inc.

SEC. 2 T. 30S R. 18W
LOC. 150' NW of C SW SW

FARM Fincham NO. 1


RIG. NO. 3

TOTAL DEPTH 3675'

COMM. 3-15-74

COMP. 3-23-74

COUNTY Kiowa
KANSAS

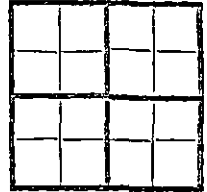

CONTRACTOR Rains & Williamson Oil Co., Inc.

CASING

20 10
15 8-5/8" @ 406' with 250 sx., 2% gel,
12 6 3% cc.
13 5

ELEVATION 2073 KB

PRODUCTION D & A

FIGURES INDICATE BOTTOM OF FORMATIONS

Sand and Shale	373
Anhydrite	387
Red Bed, Sand, and Shale	1095
Shale and Shells	1309
Shale	1820
Shale and Lime	2390
Lime and Shale	2430
Shale and Lime	2465
Lime and Shale	2873
Lime	3015
Lime and Shale	3675
<u>Rotary Total Depth</u>	<u>3675</u>

RECEIVED
STATE CORPORATION COMMISSION
MAR 29 1974
CONSERVATION DIVISION
Wichita, Kansas

State of KANSAS
County of SEDGWICK ss:

I, Wilson Rains, President of the Rains & Williamson Oil Co., Inc.

upon oath state that the above and foregoing is a true and correct copy of the log of the Fincham #1 well.

Wilson Rains
WILSON RAINS

19 74

Juanita M. Green
NOTARY PUBLIC

Juanita M. Green



Subscribed and sworn to before me this 25th day of March

My Commission Expires: October 4, 1975