

STATE OF KANSAS
STATE CORPORATION COMMISSION


15.097.20425.00.00

WELL PLUGGING RECORD

Give All Information Completely
Make Required Affidavit
Mail or Deliver Report to
Conservation Division
State Corporation Comm.
245 North Water
Wichita, KS 67202

KIOWA County, Sec. 36 Twp. 30S Rge. 17 E/W
Location as "NE/CNW $\frac{1}{4}$ SW $\frac{1}{4}$ " or footage from lines
1250' F S L and 1250 F E L

Lease Owner TEXAS OIL AND GAS CORPORATION
Lease Name GRB Well No. A - 1
Office Address 200 W Douglas, Suite 300, Wichita
Character of Well (Completed as Oil, Gas or Dry Hole) _____

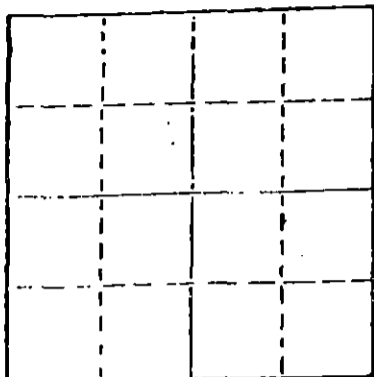

Locate well correctly on above
Section Plat

Gas
Date Well completed 11-14 1977
Application for plugging filed X Sep. 1978
Application for plugging approved Sep. 1978
Plugging commenced 11-6 1978
Plugging completed 12-4 1978
Reason for abandonment of well or producing formation _____

If a producing well is abandoned, date of last production
_____ 19____

Was permission obtained from the Conservation Division or
its agents before plugging was commenced? YES

Name of Conservation Agent who supervised plugging of this well BILL OWENS
Producing formation _____ Depth to top _____ Bottom _____ Total Depth of Well 5008
Show depth and thickness of all water, oil and gas formations.

OIL, GAS OR WATER RECORDS

CASING RECORD

FORMATION	CONTENT	FROM	TO	SIZE	PUT IN	PULLED OUT
				8 5/8	501	NONE
				4 1/2	5004	2029

Describe in detail the manner in which the well was plugged, indicating where the mud fluid
was placed and the method or methods used in introducing it into the hold. If cement or other
plugs were used, state the character of same and depth placed, from _____ feet to
_____ feet for each plug set.

ALLIED.- PUMPED IN 50 SACKS OOM CEMENT. ALLIED PUMPED IN 3 sacks hulls, 20 sacks
jell. 150 sacks of 64 - 40 POZ.

RECEIVED
STATE CORPORATION COMMISSION

DEC 28 1978

CONSERVATION DIVISION
Wichita, Kansas

(If additional description is necessary, use BACK of this sheet)

Name of Plugging Contractor CLARKE CORPORATION


STATE OF KANSAS COUNTY OF SEDGWICK, ss.
VICTOR C. SMITH of Texas Oil & Gas Corp. (employee of owner) or (owner or operator)
of the above-described well, being first duly sworn on oath, says: That I have knowledge of
the facts, statements, and matters herein contained and the log of the above-described well
as filed and that the same are true and correct. So help me God.

(Signature) Victor C. Smith
VICTOR C. SMITH of Texas Oil & Gas Corp.
200 W. Douglas, (Address) Suite 300, Wichita, KS
67202

SUBSCRIBED AND SWORN TO before me this 27th day of December, 1978

Elizabeth A. Cauley
ELIZABETH A. CAULEY Notary Public.

My commission expires January 23, 1980

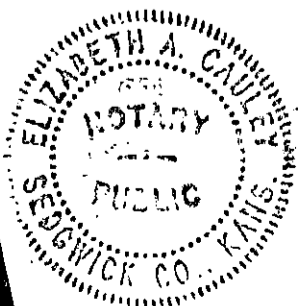

GRB 'A' No. 1

15.097.20425.00.00

1250' F58EL, Sec 36, 305-17 W

Kiowa Co., Kan

Elev: K.B. = 2119'

G.L. = 2111'

5/8" @ 501' K.B.

RECEIVED
STATE CORPORATION COMMISSION

SEP-29-1978

CONSERVATION DIVISION
Wichita, Kansas

4970
4980

~~Emt 1000~~ @ 4980' K.B.

4997, PCD (emt ret)

4 1/2", 10.5 lb, K-55, ST&C

@ 5004' K.B. w/125.5x

R.T.D. 5008'