

STATE OF KANSAS
STATE CORPORATION COMMISSION

Give All Information Completely
Make Required Affidavit
Mail or Deliver Report to:
Conservation Division
State Corporation Commission
211 No. Broadway
Wichita, Kansas

WELL PLUGGING RECORD

KIOWA County, Sec. 22 Twp. 30s Rge. 17W (## (W) X

Location as "NE/CNW/SW" or footage from lines APPROX. C-SW

Lease Owner PETROLEUM, INC.

Lease Name RUNNYMEDE UNIT "C" Well No. 1

Office Address ROUTE 2, GREAT BEND, KANSAS

Character of Well (completed as Oil, Gas or Dry Hole) DRY HOLE

Date well completed OCTOBER 17, 19 62

Application for plugging filed OCTOBER 17, 19 62

Application for plugging approved OCTOBER 17, 19 62


Plugging commenced OCTOBER 17, 19 62

Plugging completed OCTOBER 17, 19 62

Reason for abandonment of well or producing formation NO PRODUCIBLE FORMATIONS.

If a producing well is abandoned, date of last production NONE 19

Was permission obtained from the Conservation Division or its agents before plugging was commenced? YES

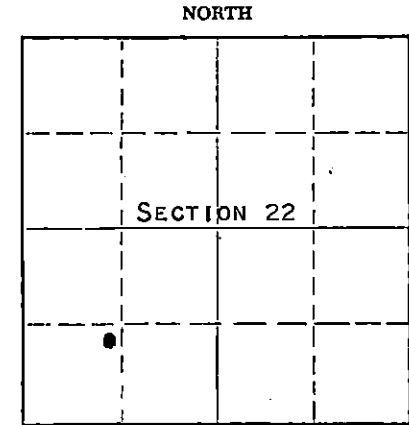

Locate well correctly on above Section Plat

Name of Conservation Agent who supervised plugging of this well HERMAN JUSTUS

Producing formation Depth to top Bottom Total Depth of Well 4911 Feet

Show depth and thickness of all water, oil and gas formations.

OIL, GAS OR WATER RECORDS

CASING RECORD

FORMATION	CONTENT	FROM	TO	SIZE	PUT IN	PULLED OUT
				8-5/8"	518'	NONE

Describe in detail the manner in which the well was plugged, indicating where the mud fluid was placed and the method or methods used in introducing it into the hole. If cement or other plugs were used, state the character of same and depth placed, from feet to feet for each plug set.

MUDDER UP WITH HEAVY MUD TO 250' FOLLOWED BY WOODEN PLUG & 1/4 SACK HULLS. PLACED 25 SACKS CEMENT THROUGH DRILL PIPE ONTO HULLS. MUDDER UP WITH HEAVY MUD TO 40' FOLLOWED BY WOODEN PLUG, 1/4 SACK HULLS AND 10 SACKS CEMENT TO BASE OF WELL CELLAR.

RECEIVED
STATE CORPORATION COMMISSION

NOV 12 1962

CONSERVATION DIVISION
Wichita, Kansas

11/12/62

(If additional description is necessary, use BACK of this sheet)

Name of Plugging Contractor GARVEY DRILLING COMPANY

Address ROUTE 2, GREAT BEND, KANSAS

STATE OF KANSAS, COUNTY OF BARTON, ss.

DON SEARLE

(employee of owner) or of the above-described well, being first duly sworn on oath, says: That I have knowledge of the facts, statements, and matters herein contained and the log of the above-described well as filed and that the same are true and correct. So help me God. DON SEARLE, DIST. PROD. SUPT.

(Signature) Don Searle

ROUTE 2, GREAT BEND, KANSAS

(Address)

SUBSCRIBED AND SWORN to before me this 7TH day of NOVEMBER, 19 62

Arthur J. Miles

My commission expires APRIL 14, 1963

Notary Public.



WELL LOG

15.097.10149.00.00

COMPANY PETROLEUM, INCORPORATED

SEC. 22 T. 30S R. 17W

FARM RUNNYMEDE UNIT "C" NO. 1

LOC. C-SW/4


TOTAL DEPTH 4911'

COUNTY Kiowa Co., Kansas

COMM. October 3, 1962

COMP. October 17, 1962

CONTRACTOR GARVEY DRILLING COMPANY

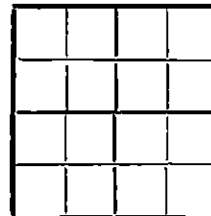

CASING 8-5/8" @ 518' w/300 sax.

ELEVATION 1974' D.F.

PRODUCTION D & A

FIGURES INDICATE BOTTOM OF FORMATIONS

45	Surface clay
60	Clay & sand
215	Red bed
235	Anhydrite
600	Shale & shells
900	Red bed & shells
930	Anhydrite
1000	Shale & shells
1030	Shale
1200	Red bed & shale
1880	Shells & shale
2210	Shale & shells w/lime streaks
2475	Lime
2595	Lime & shale
2925	Lime
3070	Lime & shale
3400	Shale & lime
3820	Lime & shale
4217	Shale & lime
4292	Lime & shale
4871	Lime
4881	Chat
4911=	Lime
4911	T. D.

RECEIVED
 STATE CORPORATION COMMISSION
 NOV 12 1962
 CONSERVATION DIVISION
 Wichita, Kansas

State of KANSAS }
 County of BARTON } ss

I, VERNE A. MORRIS of GARVEY DRILLING COMPANY

upon oath state the above and foregoing is a true and correct copy of the log of the #1 RUNNYMEDE UNIT "C" well.

Verne A. Morris

Subscribed and sworn to before me this 5th day of November 1962

My Commission Expires: April 14, 1963

Arthur J. Wiles
 NOTARY PUBLIC