


STATE OF KANSAS
STATE CORPORATION COMMISSION

WELL PLUGGING RECORD

Give All Information Completely
Make Required Affidavit
Mail or Deliver Report to:
Conservation Division
State Corporation Commission
212 North Market, Insurance Bldg.
Wichita, Kansas

Kiowa County, Sec. 19 Twp. 30S Rge. (E) 17 (W)
Location as "NE/CNW/SW" or footage from lines 838' WEL & 713' NSL of SE/4
Lease Owner Gulf Oil Corporation
Lease Name R. Booth Well No. 1
Office Address Box 2233, Wichita, Kansas
Character of Well (completed as Oil, Gas or Dry Hole) Dry Hole
Date well completed October 18, 1958
Application for plugging filed November 20, 1958
Application for plugging approved November 21, 1958
Plugging commenced November 25, 1958
Plugging completed November 29, 1958
Reason for abandonment of well or producing formation Dry Hole

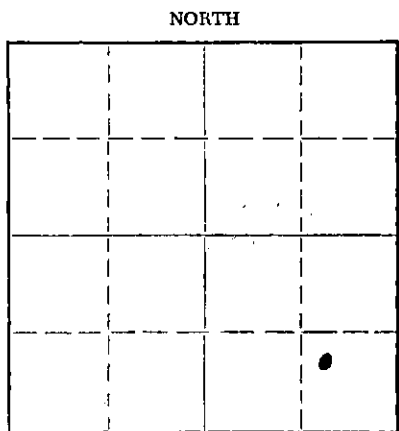

Locate well correctly on above
Section Plat

If a producing well is abandoned, date of last production ----- 19____
Was permission obtained from the Conservation Division or its agents before plugging was com-
menced? Yes

Name of Conservation Agent who supervised plugging of this well W. L. Lackamp
Producing formation ----- Depth to top ----- Bottom ----- Total Depth of Well 5073 Feet
Show depth and thickness of all water, oil and gas formations. PBTD 5032'

OIL, GAS OR WATER RECORDS

CASING RECORD

FORMATION	CONTENT	FROM	TO	SIZE	PUT IN	PULLED OUT
				8-5/8"	770'	-0-
				5-1/2"	5072'	3017'

Describe in detail the manner in which the well was plugged, indicating where the mud fluid was placed and the method or methods used in introducing it into the hole. If cement or other plugs were used, state the character of same and depth placed, from _____ feet to _____ feet for each plug set.

PBTD 5032'. Spotted 50 sacks Pozmix on bottom. Mudded hole to 450'.
Set 10' Rock bridge. Dumped 20 sacks cement to 390'. Filled with mud
to 40'. Set Rock bridge from 40' to 30'. Capped with 10 sacks cement.

(If additional description is necessary, use BACK of this sheet)

Name of Plugging Contractor Morgan Well Plugging Service
Address 102 West 18th Street, Hutchinson, Kansas

STATE OF Kansas, COUNTY OF Sedgwick, ss.
Thomas A. Trax (employee of owner) or (owner or operator) of the above-described well, being first duly sworn on oath, says: That I have knowledge of the facts, statements, and matters herein contained and the log of the above-described well as filed and that the same are true and correct. So help me God.

(Signature) [Signature]
Box 2233, Wichita, Kansas
(Address)

SUBSCRIBED AND SWORN TO before me this 1st day of December, 1958

My commission expires 6-3-61

[Signature]
C.C. Lewis, Notary Public.

RECEIVED
STATE CORPORATION COMMISSION

DEC 2 - 1958

CONSERVATION DIVISION
Wichita, Kansas

PLUGGING
FILE SEC. 19 T 30 R 17 W
BOOK PAGE 146 LINE 39

WELL LOG

COMPANY: Gulf Oil Corporation
 FARM: R. Booth No. 1
 TOTAL DEPTH: 5,067'
 COMM: 8-23-58. COMP: 10-17-58.

Sec. 19-30S-17W
 Loc. C SE SE
 County - Kiowa

CASINO

8-5/8" - 770'
 5-1/2" - 5067'

ELEVATION

R.K.B. - 2077'
 Gr. - 2069'

DRILLER'S LOG

Surface Soil, Sand & Red Bed	0	330
Red Bed & Sand	330	529
Sand, Shale & Shells	529	682
Red Bed	682	962
Red Bed & Sand	962	995
Red Bed & Lime Shells	995	1361
Shale, Shells & Sand	1361	1685
Shale & Shells	1685	1928
Shale & Lime	1928	2314
Lime	2314	2386
Lime & Shale	2386	2563
Lime	2563	2604
Shale & Lime	2604	3435
Lime	3435	3585
Shale & Lime	3585	3690
Lime	3690	3866
Shale	3866	3890
Shale & Lime	3890	4166
Sdy. Lime & Shale	4166	4276
Shale & Lime	4276	4332
Lime	4332	4502
Lime & Shale	4502	4543
Lime	4543	4684
Lime & Shale	4684	4704
Lime	4704	4824
Lime & Shale	4824	4875
Lime	4875	5056
Lime & Shale	5056	5067
 Total Depth		 5067

PLUGGING
 FILE SEC 19 T30 R17W
 BOOK PAGE 146 LINE 39

RECEIVED
 STATE COMMISSIONER OF GEOL. & MIN. IND.
 DEC 5 - 1958
 CONSERVATION DIVISION
 Wichita, Kansas