

STATE OF KANSAS
STATE CORPORATION COMMISSION


WELL PLUGGING RECORD

Give All Information Completely
Make Required Affidavit
Mail or Deliver Report to:
Conservation Division
State Corporation Commission
211 No. Broadway
Wichita, Kansas

KIOWA County, Sec. 17 Twp. 30S Rge. 17W (W)

Location as "NE/CNW/SW" or footage from lines C SE NW
Lease Owner PETROLEUM, INC.,
Lease Name KANE Well No. 1
Office Address R.R. #2, GREAT BEND, KANSAS
Character of Well (completed as Oil, Gas or Dry Hole) DRY HOLE
Date well completed 6-16- 1963
Application for plugging filed 9-13- 1963
Application for plugging approved 9-16- 1963
Plugging commenced 9-16- 1963
Plugging completed 9-26- 1963
Reason for abandonment of well or producing formation NO PRODUCIBLE ZONES

NORTH

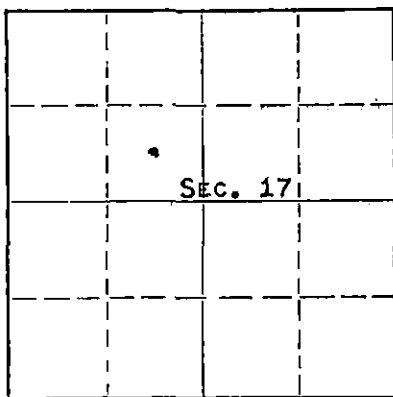

Locate well correctly on above
Section Plat

If a producing well is abandoned, date of last production NONE 19
Was permission obtained from the Conservation Division or its agents before plugging was commenced? YES

Name of Conservation Agent who supervised plugging of this well A. ELVING, BOX 248, PRATT, KANSAS
Producing formation - - Depth to top - - Bottom - - Total Depth of Well 4978 Feet
Show depth and thickness of all water, oil and gas formations.

OIL, GAS OR WATER RECORDS

CASING RECORD

FORMATION	CONTENT	FROM	TO	SIZE	PUT IN	PULLED OUT
MISSISSIPPI CHERT	WATER WITH A LITTLE GAS	4886	4900	10-3/4	215	NONE
				4-1/2	4975	4094'

Describe in detail the manner in which the well was plugged, indicating where the mud fluid was placed and the method or methods used in introducing it into the hole. If cement or other plugs were used, state the character of same and depth placed, from feet to feet for each plug set.

FILLED HOLE WITH CRUSHED ROCK FROM 4978 TO 4855', PLACED 3 SACKS CEMENT ON TOP OF ROCK, MUD UP TO 210' AND MADE A 10' ROCK BRIDGE. PLACED 30 SACKS CEMENT ON TOP OF ROCK BRIDGE, MUD UP TO 30' & MADE SOLID ROCK BRIDGE. FILLED HOLE TO BASE OF WELL CELLAR WITH 10 SACKS OF CEMENT.

RECEIVED
STATE CORPORATION COMMISSION

OCT 4 1963 10-4-63

CONSERVATION DIVISION
Wichita, Kansas

(If additional description is necessary, use BACK of this sheet)
Name of Plugging Contractor SOUTHWEST CASING PULLING CO., INC.
Address BOX 364, GREAT BEND, KANSAS

STATE OF KANSAS, COUNTY OF BARTON, ss.
DON SEARLE (employee of owner) or (owner) of the above-described well, being first duly sworn on oath, says: That I have knowledge of the facts, statements, and matters herein contained and the log of the above-described well as filed and that the same are true and correct. So help me God. DON SEARLE, DIST. PROD. SUPT.

(Signature) Don Searle
R. R. #2, GREAT BEND, KANSAS
(Address)

SUBSCRIBED AND SWORN TO before me this 2ND day of OCTOBER, 1963

My commission expires APRIL 14, 1967

Notary Public.

WELL LOG 15.097.00230.00.01

COMPANY Petroleum Inc

SEC. 17 T. 30S R. 17W

FARM Kane

NO. 1 (Washdown)

LOC. C SE NW

TOTAL DEPTH 4978'

COUNTY Kiowa

COMM. 5-24-63

COMP. 5-27-63

CONTRACTOR Garvey Drilling Company

CASING 4 1/2" @ 4975' w/150 sx

ELEVATION 2041' D.F.

PRODUCTION Mississippi

FIGURES INDICATE BOTTOM OF FORMATIONS

This well previously drilled by Messman-Rinehart, commenced 3-6-60, and D. & A. on 4-1-60. RTD 4978'.

RECEIVED
STATE CORPORATION COMMISSION

OCT 4 1963

CONSERVATION DIVISION
Wichita, Kansas

State of Kansas }
County of Barton } SS

I, Sam N. Stephens of Garvey Drilling Company

upon oath state the above and foregoing is a true and correct copy of the log of the Kane #1 (Washdown) well.

Sam N. Stephens

Subscribed and sworn to before me this 5th day of June 19 63

My Commission Expires: April 14th, 1967

Arthur J. Wiles
NOTARY PUBLIC