


STATE OF KANSAS
STATE CORPORATION COMMISSION

WELL PLUGGING RECORD

Give All Information Completely
Make Required Affidavit
Mail or Deliver Report to:
Conservation Division
State Corporation Commission
212 North Market, Insurance Bldg.
Wichita, Kansas

Kiowa County, Sec. 17 Twp. 30S Rge. (E) 17 (W)
Ctr. SE/4 NW/4

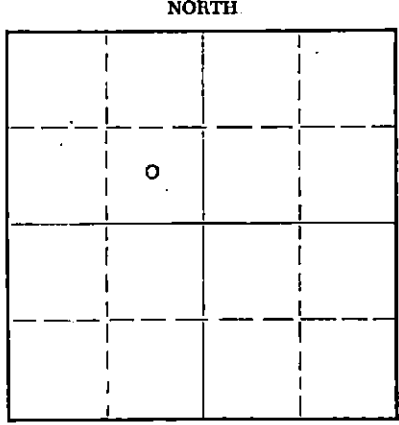

Locate well correctly on above
Section Plat

Location as "NE/CNW%SW%" or footage from lines
Lease Owner: Messman-Rinehart Oil Company
Lease Name: Kane Ranch "F" Well No. 1
Office Address: 518 Petroleum Building, Wichita, Kansas
Character of Well (completed as Oil, Gas or Dry Hole): Dry
Date well completed: March 23 19 60
Application for plugging filed: March 23 19 60
Application for plugging approved: March 23 19 60
Plugging commenced: March 24 19 60
Plugging completed: March 24 19 60
Reason for abandonment of well or producing formation: Dry

If a producing well is abandoned, date of last production: 19
Was permission obtained from the Conservation Division or its agents before plugging was commenced? yes

Name of Conservation Agent who supervised plugging of this well: Fred W. Hampel, Pretty Prairie, Kansas
Producing formation: Depth to top: Bottom: Total Depth of Well: 4978 Feet
Show depth and thickness of all water, oil and gas formations.

OIL, GAS OR WATER RECORDS

CASING RECORD

FORMATION	CONTENT	FROM	TO	SIZE	PUT IN	PULLED OUT
				10-3/4"	215'	none

Describe in detail the manner in which the well was plugged, indicating where the mud fluid was placed and the method or methods used in introducing it into the hole. If cement or other plugs were used, state the character of same and depth placed, from feet to feet for each plug set.

Mud to 210 ft., set plug and 210 ft. with 1/4 sk. hulls and 25 sx. cement, Mud to 35 ft., set plug at 35 ft. with 1/4 sk. hulls and 15 sx. cement., 2 sx. cement in rat hole.

RECEIVED
STATE CORPORATION COMMISSION
APR 13 1960
CONSERVATION DIVISION
Wichita, Kansas
4-13-60

(If additional description is necessary, use BACK of this sheet)
Name of Plugging Contractor: Messman-Rinehart Oil Company
Address: 518 Petroleum Building, Wichita, Kansas

STATE OF Kansas, COUNTY OF Sedgwick, ss.
J. A. Gilliland (employee of owner) of the above-described well, being first duly sworn on oath, says: That I have knowledge of the facts, statements, and matters herein contained and the log of the above-described well as filed and that the same are true and correct. So help me God.

(Signature) J. A. Gilliland
518 Petroleum Building, Wichita, Kansas (Address)

SUBSCRIBED AND SWORN TO before me this 6th day of April, 19 60
Barbara J. Scott, Notary Public.

My commission expires December 1, 1960


NO. 1 KANE RANCH "F"

Well Record:

Location: SE/4 NW/4,
Sec. 17-30S-17W
Kiowa County, Kansas

Commenced: March 6, 1960
Completed: March 24, 1960

Operator: Messman-Rinehart Oil Company
518 Petroleum Building
Wichita, Kansas

Elevation: 2039' K/B
Production: D & A

Contractor: Messman-Rinehart Oil Company
518 Petroleum Building
Wichita, Kansas

Casing Record: 10-3/4" @ 215' w/150 sx. cem.

=== LOG ===

Clay & Rocks	70
Shale & Shells	215
Shale & Shells	335
Anhydrite	350
Shale, Shells & Red Bed	970
Anhydrite	1005
Shale & Shells	1080
Red Bed, Shale & Shells	1650
Shale & Shells	2015
Lime & Shale	2180
Lime	3060
Lime & Shale	3750
Lime	3880
Lime & Shale	4315
Lime	4792
Lime & Shale	4869
Lime & Chert	4900
Chert	4920
Lime & Chert	4965
Lime	4978 R.T.D.

Sample Tops:

4062 - Heebner (-2023)
4222 - Brown Lime (-2184)
4241 - Lansing (-2202)
4868 - Mississippi Chat (-2829)
4904 - Mississippi Lime (-2865)

RECEIVED
STATE COMMISSION
APR 13 1960
CONSERVATION DIVISION
Wichita, Kansas

The undersigned, MESSMAN-RINEHART OIL COMPANY, hereby certifies that the above log is a true and correct log of the formation encountered in drilling the above well as reflected by the Daily Drilling Reports.

MESSMAN-RINEHART OIL COMPANY

BY: 

J. A. Gilliland

Subscribed and sworn to before me
this 12th day of April, 1960.


Barbara J. Scott

My Commission Expires: December 1, 1960