


WELL PLUGGING RECORD

Give All Information Completely
Make Required A.E. Javit
Mail or Deliver Report to:
Conservation Division
State Corporation Commission
211 No. Broadway
Wichita, Kansas

NORTH

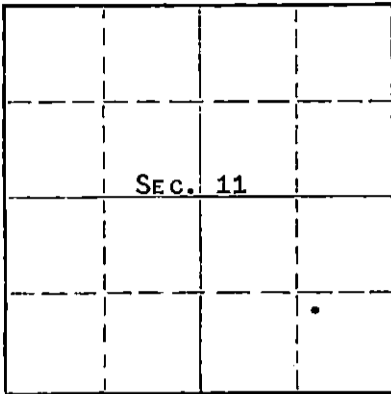

Locate well correctly on above
Section Plat

Location as "NE/CNW/SW" or footage from lines KIOWA County. Sec. 11 Twp. 30S Rge. 17 (X) (W)
APP. SE
Lease Owner PETROLEUM, INC.
Lease Name RUNNYMEDE UNIT "D" Well No. 1
Office Address R.R. #2, GREAT BEND, KANSAS
Character of Well (completed as Oil, Gas or Dry Hole) DRY HOLE
Date well completed DEC. 30 19 65
Application for plugging filed DEC. 30 19 65
Application for plugging approved DEC. 30 19 65
Plugging commenced DEC. 30 19 65
Plugging completed DEC. 30 19 65
Reason for abandonment of well or producing formation NO PRODUCIBLE ZONE

If a producing well is abandoned, date of last production NONE 19
Was permission obtained from the Conservation Division or its agents before plugging was commenced? YES

Name of Conservation Agent who supervised plugging of this well ARCHIE ELVING
Producing formation _____ Depth to top _____ Bottom _____ Total Depth of Well 5001' Feet
Show depth and thickness of all water, oil and gas formations.

OIL, GAS OR WATER RECORDS

CASING RECORD

FORMATION	CONTENT	FROM	TO	SIZE	PUT IN	PULLED OUT
				8-5/8"	524'	NONE

Describe in detail the manner in which the well was plugged, indicating where the mud fluid was placed and the method or methods used in introducing it into the hole. If cement or other plugs were used, state the character of same and depth placed, from _____ feet to _____ feet for each plug set.

MUDDED UP WITH HEAVY MUD TO 300', FOLLOWED BY BRIDGE, PLACED 25 SACKS CEMENT ON TOP OF BRIDGE. MUDDED UP WITH HEAVY MUD TO 40', FOLLOWED BY BRIDGE, PLACED 10 SACKS CEMENT ON TOP OF BRIDGE TO BASE OF WELL CELLAR.

1-17-66

STATE CORPORATION COMMISSION
JAN 17 1966
CONSERVATION DIVISION
Wichita, Kansas

(If additional description is necessary, use BACK of this sheet)

Name of Plugging Contractor GARVEY DRILLING COMPANY
Address R.R. #2, GREAT BEND, KANSAS

STATE OF KANSAS, COUNTY OF BARTON, ss.
MONTE CHADD (employee of owner) or (~~owner or operator~~) of the above-described well, being first duly sworn on oath, says: That I have knowledge of the facts, statements, and matters herein contained and the log of the above-described well as filed and that the same are true and correct. So help me God. MONTE CHADD, DIST. PROD. SUPT.
(Signature) Monte Chadd

R.R. #2, GREAT BEND, KANSAS
(Address)

SUBSCRIBED AND SWORN TO before me this 14 day of JANUARY, 19 66

Richard H. Duncker
Notary Public.

My commission expires MAY 28, 1969

WELL LOG

COMPANY Petroleum, Inc.

SEC. 11 T. 30S R. 17W

FARM Runnymede Unit

NO. D-1

LOC. App C SE


TOTAL DEPTH 5001'

COUNTY Kiowa

COMM. 12-13-65

COMP. 12-30-65

CONTRACTOR Garvey Drilling Company

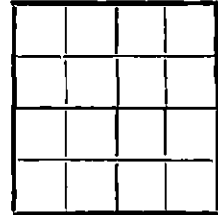

CASING 8 5/8" @ 524' w/300 sx

ELEVATION 1951' KB

PRODUCTION D & A.

FIGURES INDICATE BOTTOM OF FORMATIONS

- 40' Shale
- 340' Red Rock and Gyp
- 1100' Red Bed and Shale
- 1575' Shale and Red Bed
- 1870' Shale and Lime Streaks
- 2060' Shale and Lime
- 2205' Lime and Shale
- 2800' Lime
- 3470' Lime and Shale
- 3600' Lime and Shale w/Chalk Streaks
- 4242' Lime and Shale
- 4698' Lime
- 4746' Lime and Shale
- 4784' Cherokee
- 4805' Lime and Shale
- 4839' Lime
- 4892' Lime and Shale
- 4898' Lime, Shale, and Chert
- 4938' Lime and Chert
- 4974' Lime, Shale, and Chert
- 5001' Lime with Chert
- 5001' RTD

RECEIVED
STATE CORPORATION COMMISSION

JAN 17 1966

CONSERVATION DIVISION
Wichita, Kansas

State of Kansas
County of Barton } SS

I, Sam N. Stephens of Garvey Drilling Company

upon oath state the above and foregoing is a true and correct copy of the log of the Runnymede Unit D-1 well.

Sam N. Stephens

Subscribed and sworn to before me this 13th day of January 19 66

My Commission Expires: November 5, 1969

Richard A. Doy
NOTARY PUBLIC