

STATE OF KANSAS  
STATE CORPORATION COMMISSION

Form CP-4

Give All Information Completely -  
Make Required Affidavit  
Mail or Deliver Report to:  
Conservation Division  
State Corporation Commission  
212 No. Market  
Wichita, Kansas 67202

WELL PLUGGING RECORD

Stafford County. Sec. 36 Twp. 21 Rge. 12 (E) (W) x

Location as "NE/CNW/SW" or footage from lines CWL SW

Lease Owner Thos. H. Allan

Lease Name Mellies Well No. #1

Office Address 925 Union Center Wichita, Kansas 67202

Character of Well (completed as Oil, Gas or Dry Hole) \_\_\_\_\_

Date well completed \_\_\_\_\_ 19 \_\_\_\_\_

Application for plugging filed \_\_\_\_\_ 19 \_\_\_\_\_

Application for plugging approved \_\_\_\_\_ 19 \_\_\_\_\_


Plugging commenced 8-19-71 19 \_\_\_\_\_

Plugging completed 8-23-71 19 \_\_\_\_\_

Reason for abandonment of well or producing formation \_\_\_\_\_

If a producing well is abandoned, date of last production \_\_\_\_\_ 19 \_\_\_\_\_

Was permission obtained from the Conservation Division or its agents before plugging was commenced? \_\_\_\_\_

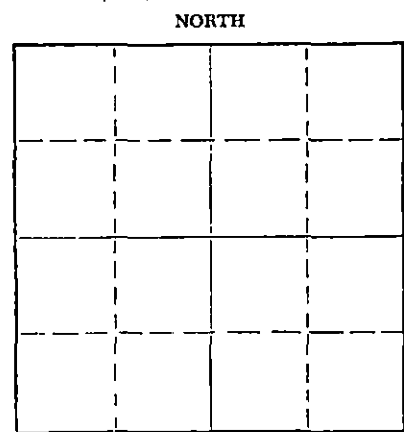

Locate well correctly on above  
Section Plat

Name of Conservation Agent who supervised plugging of this well G. R. Biberstein

Producing formation \_\_\_\_\_ Depth to top \_\_\_\_\_ Bottom \_\_\_\_\_ Total Depth of Well 3578' Feet

Show depth and thickness of all water, oil and gas formations.

OIL, GAS OR WATER RECORDS

CASING RECORD

FORMATION	CONTENT	FROM	TO	SIZE	PUT IN	PULLED OUT
				5 1/2"	3561'	1588.76'
				10"	200'	

Describe in detail the manner in which the well was plugged, indicating where the mud fluid was placed and the method or methods used in introducing it into the hole. If cement or other plugs were used, state the character of same and depth placed, from \_\_\_\_\_ feet to \_\_\_\_\_ feet for each plug set.

Made bottom hole plug back with sand to 3540'. Mixed and ran 5 sacks cement thru dump bailer.

Squeezed hole with 3 sacks hulls - 25 sacks gel. Released plug and displaced with 125 sacks cement.

RECEIVED  
STATE CORPORATION COMMISSION  
AUG 24 1971  
CONSERVATION DIVISION  
Wichita, Kansas

(If additional description is necessary, use BACK of this sheet)

Name of Plugging Contractor Southwest Casing Pulling Co.

Address Box 364 Great Bend, Kansas

STATE OF Kansas, COUNTY OF Barton, ss.

Southwest Casing Pulling Co. (employee of owner) or (owner or operator) of the above-described well, being first duly sworn on oath, says: That I have knowledge of the facts, statements, and matters herein contained and the log of the above-described well as filed and that the same are true and correct. So help me God.


(Signature) W. C. Spencer Sec.

Box 364 Great Bend, Kansas  
(Address)

SUBSCRIBED AND SWORN to before me this 23 day of August, 19 71

Sidney D. Miller  
Notary Public.

My commission expires 1972

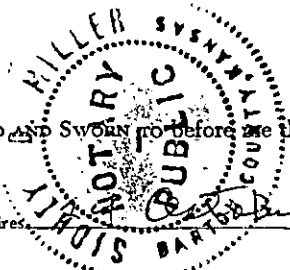


WELL LOG-BUREAU OF KANSAS GEOLOGICAL SURVEY  
412 Union National Bldg., Wichita, Kansas

J. E. TRIGO ET AL  
Well No. 1.

SEC. 33 T. 21 R. 12W  
CWL SW

Total Depth. 3578'  
Comm. 11-12-39 Comp. 12-11-39  
Shot or Treated. 1000 & 2500 Gals.  
Contractor.  
Issued. 1-8-40

County. Stafford

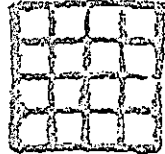

CASING:  
10" 200' ? wt  
26" 5 1/2" 3561' - 9" hole - 125' sk

Elevation.

Production. Pot. 423 B.

Figures Indicate Bottom of Formations.

surface	200
red beds	580
lime	601
red beds	830
shale & shells	1365
salt	1450
shale & shells	1610
lime	1668
shale & shells	1770
lime	1914
shale & shells	1981
lime	2052
shale & shells	2257
lime	2300
shale	2464
lime	2474
shale & shells	2495
lime	2598
shale	2727
lime	2751
shale & shells	2889
lime	2995
shale	3086
lime	3172
shale	3193
lime	3203
shale	3235
lime	3505
shale sticky	3555
lime	3578
Total Depth.	

RECEIVED  
STATE CORPORATION COMMISSION  
JUL 30 1971  
CONSERVATION DIVISION  
Wichita, Kansas

Acidized 1st w/1000 Gals.  
Acidized 2nd w/2500 Gals.  
Pumped Potential 423 Bbls,  
46° gravity

Sample Tops:  
Anhydrite 580  
Ft. Riley 1720  
Neva 2105  
Topeka 2832  
Lansing 3234  
Conglomerate 3492  
Simpson 3511  
Artuckle 3559 Corr.

*Handwritten signature or initials*