

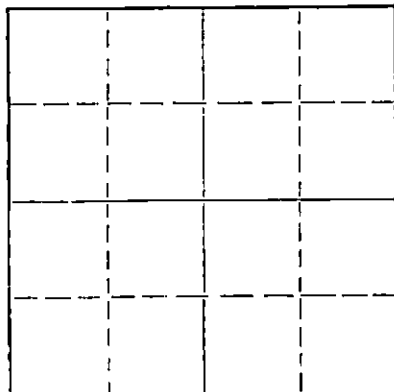
STATE OF KANSAS  
STATE CORPORATION COMMISSION

Form CP-4

Give All Information Completely  
Make Required Affidavit  
Mail or Deliver Report to:  
Conservation Division  
State Corporation Commission  
211 No. Broadway  
Wichita, Kansas

## WELL PLUGGING RECORD

NORTH

Locate well correctly on above  
Section Plat

Kiowa County, Sec. 30 Twp. 30 Rge. 20 (W)  
Location as "NE/CNW/SW" or footage from lines. C SE SE  
Lease Owner Fred B. Anschutz  
Lease Name Trager Well No. 1  
Office Address 1521 Wichita Plaza, Wichita, Kansas  
Character of Well (completed as Oil, Gas or Dry Hole) Dry Hole  
Date well completed 2-19 1964  
Application for plugging filed 2-19 1964  
Application for plugging approved 2-19 1964  
Plugging commenced 2-19 1964  
Plugging completed 2-19 1964  
Reason for abandonment of well or producing formation None

If a producing well is abandoned, date of last production 19  
Was permission obtained from the Conservation Division or its agents before plugging was commenced? Yes

Name of Conservation Agent who supervised plugging of this well

Producing formation Depth to top Bottom Total Depth of Well 5202 Feet

Show depth and thickness of all water, oil and gas formations.

## OIL, GAS OR WATER RECORDS

## CASING RECORD

| FORMATION | CONTENT | FROM | TO   | SIZE  | PUT IN | PULLED OUT |
|-----------|---------|------|------|-------|--------|------------|
|           |         | 0    | 321' | 8 5/8 | 314'   | -0-        |
|           |         |      |      |       |        |            |
|           |         |      |      |       |        |            |
Describe in detail the manner in which the well was plugged, indicating where the mud fluid was placed and the method or methods used in introducing it into the hole. If cement or other plugs were used, state the character of same and depth placed, from feet to feet for each plug set.

Filled hole with mud to 300', 1/2 sk. hulls,  
25 sks. cement. Filled hole to 40' 1/2 sk.  
hulls, 10 sks. cement.

RECEIVED  
STATE CORPORATION COMMISSION

MAR 2 1964  
3-2-64  
CONSERVATION DIVISION  
Wichita, Kansas

(If additional description is necessary, use BACK of this sheet)

Name of Plugging Contractor Terrel Drilling and Producing  
Address Box 606, Russell, Kansas

STATE OF KANSAS, COUNTY OF RUSSELL, ss.

(Employee or owner) or (owner or operator) of the above-described well, being first duly sworn on oath, says: That I have knowledge of the facts, statements, and matters herein contained and the log of the above-described well as filed and that the same are true and correct. So help me God.

(Signature)

Box 606, Russell, Kansas  
(Address)

SUBSCRIBED AND SWORN TO before me this 27th day of February, 1964

My commission expires 12-12-66

Notary Public.

RECEIVED  
STATE CORPORATION COMMISSION

MAR 2 1964

CONSERVATION DIVISION  
Wichita, Kansas

## W E L L L O G

OPERATOR: Fred B. Anschutz  
1521 Wichita Plaza  
Wichita, Kansas

CONTRACTOR: Terrel Drilling & Producing  
Box 606  
Russell, Kansas

LEASE: Trager #1

COMMENCED: January 20, 1964

LOCATION: C SE SE, 30-30-20W  
Kiowa County, Kansas

COMPLETED: February 20, 1964

## DEPTHS &amp; FORMATIONS

|                       |      |               |      |
|-----------------------|------|---------------|------|
| Surface Clay & Sand   | 70   | Lime          | 3116 |
| Red Bed & Shale       | 1515 | Lime & Shale  | 4218 |
| Shale & Shells        | 1955 | Lime          | 4725 |
| Shale w/ Lime Streaks | 2235 | Lime & Shale  | 4890 |
| Shale & Lime          | 2274 | Lime          | 5079 |
| Lime & Shale          | 3033 | Lime & Chert  | 5116 |
|                       |      | Lime (R.T.D.) | 5202 |

STATE OF KANSAS )  
COUNTY OF RUSSELL) ss...

Joe K. Branum, owner of Terrel Drilling and Producing, being first duly sworn on oath says: "That I have knowledge of the facts, statements and matters herein contained and the log of the above described well as filed and that the same are true and correct."

Joe K. Branum  
Joe K. Branum - TERREL DRILLING & PRODUCING

Subscribed and sworn before me this 27th day of February, 1964.

L. Lee Simpson  
Notary Public

My Commission Expires December 12, 1966