

STATE OF KANSAS
STATE CORPORATION COMMISSION

Form CP-4

Give All Information Completely
Make Required Affidavit
Mail or Deliver Report to:
Conservation Division
State Corporation Commission
211 No. Broadway
Wichita, Kansas

WELL PLUGGING RECORD

Kiowa County, Sec. 20 Twp. 30 Rge. 20 (E) W (W)

Location as "NE/CNWxSWx" or footage from lines C SW NE

Lease Owner Drillers Production Company, Inc.

Lease Name Lorimor "B" Well No. 1

Office Address Wichita, Kansas

Character of Well (completed as Oil, Gas or Dry Hole) _____

Date well completed _____ 19__

Application for plugging filed _____ 19__

Application for plugging approved _____ 19__


Plugging commenced 8-17-65 _____ 19__

Plugging completed 8-21-65 _____ 19__

Reason for abandonment of well or producing formation Depleted.

If a producing well is abandoned, date of last production _____ 19__

Was permission obtained from the Conservation Division or its agents before plugging was commenced? yes

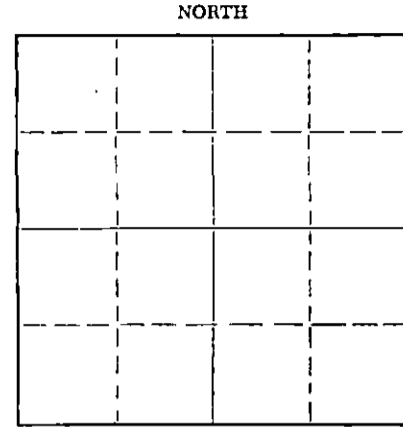

Locate well correctly on above Section Plat

Name of Conservation Agent who supervised plugging of this well Archie Elving

Producing formation _____ Depth to top _____ Bottom _____ Total Depth of Well 5295 Feet

Show depth and thickness of all water, oil and gas formations.

OIL, GAS OR WATER RECORDS

CASING RECORD

FORMATION	CONTENT	FROM	TO	SIZE	PUT IN	PULLED OUT
				8-5/8"	528'	None
				5-1/2"	5296'	4264'

Describe in detail the manner in which the well was plugged, indicating where the mud fluid was placed and the method or methods used in introducing it into the hole. If cement or other plugs were used, state the character of same and depth placed, from _____ feet to _____ feet for each plug set.

Checked hole to plug back @ 5252', sanded hole to 5150' and dumped 5 sacks of cement @ 5150' with dump bailer. Pulled 5 1/2" casing, set rock bridge from 300' to 290' and dumped 25 sacks of cement @ 290'. Mudded hole to 40', set rock bridge to 30' and ran 10 sacks of cement to base of cellar.

RECEIVED
STATE CORPORATION COMMISSION

SEP 2 1965

9-2-65
CONSERVATION DIVISION
Wichita, Kansas

PLUGGING COMPLETE.

(If additional description is necessary, use BACK of this sheet)
Name of Plugging Contractor KNIGHT CASING PULLING COMPANY
Address CHASE, KANSAS

STATE OF KANSAS COUNTY OF RICE, ss.
Noel J. Knight (employee of owner) or (~~owner~~) of the above-described well, being first duly sworn on oath, says: That I have knowledge of the facts, statements, and matters herein contained and the log of the above-described well as filed and that the same are true and correct. So help me God.

(Signature) Noel J. Knight
Chase, Kansas
(Address)

SUBSCRIBED AND SWORN TO before me this 24th day of August, 1965

My commission expires May 20, 1968

Milton J. Volin
Notary Public.

DRILLERS LOG

No. 1 Lorimor "B"

CASING RECORD:	COMPANY:	DRILLERS PRODUCTION CO., INC.	DESCRIPTION:
8 5/8" @ 528.37' w/425 sx cement	CONTRACTOR:	Red Tiger Drilling Co.	C SW NE 20-30S-20W Kiowa Co., Ks.
5 1/2" @ 5296' w/200 sx cement	COMMENCED:	May 2, 1965	ELEVATION: 2283 DF 2286 RB
TOTAL DEPTH: 5296'	COMPLETED:	May 20, 1965	

<u>FORMATION</u>	<u>FROM</u>	<u>TO</u>	<u>REMARKS</u>
Sand & Shale	0	140	
Shale & Redbed w/Sand Streaks	140	450	
Anhydrite	450	468	
Shale	468	535	
Redbed	535	625	
Redbed & Shells	625	1265	
Shale & Shells	1265	1700	
Shale Salt & Shells	1700	2140	
Shale & Shells	2140	2300	
Shale & Lime	2300	3980	
Lime	3980	4370	
Lime & Shale	4370	4513	
Lime	4513	5296	

RECEIVED
STATE CORPORATION COMMISSION
SEP 2 1965
CONSERVATION DIVISION
Wichita, Kansas

I certify that this is a true and correct copy of the above log to the best of my knowledge.,

RED TIGER DRILLING COMPANY

Maxine V. Head
Maxine V. Head

Subscribed and sworn to before me this 21st day of May, 1965.

Jean Hollas
Notary Public

My Commission Expires:

5-22-66