


STATE OF KANSAS
STATE CORPORATION COMMISSION

Give All Information Completely
Make Required Affidavit
Mail or Deliver Report to:
Conservation Division
State Corporation Commission
800 Bitting Building
Wichita, Kansas

WELL PLUGGING RECORD

Kiowa County. Sec. 20 Twp. 30 Rge. (E)20 (W)
Location as "NE/CNW $\frac{1}{2}$ SW $\frac{1}{4}$ " or footage from lines NW NW NE/4
Lease Owner M. B. Armer
Lease Name Lorimor Well No. 1
Office Address 710 Petroleum Bldg., Wichita, Kansas
Character of Well (completed as Oil, Gas or Dry Hole) dry
Date well completed July 18, 19 53
Application for plugging filed July 18, 19 53
Application for plugging approved July 18, 19 53
Plugging commenced July 18, 19 53
Plugging completed July 18, 19 53
Reason for abandonment of well or producing formation dry

NORTH

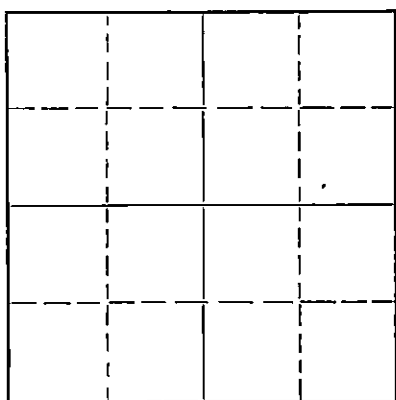

Locate well correctly on above
Section Plat

If a producing well is abandoned, date of last production _____ 19____
Was permission obtained from the Conservation Division or its agents before plugging was com-
menced? YES

Name of Conservation Agent who supervised plugging of this well M. A. Rives
Producing formation _____ Depth to top _____ Bottom _____ Total Depth of Well 5260 Feet
Show depth and thickness of all water, oil and gas formations.

OIL, GAS OR WATER RECORDS

CASING RECORD

FORMATION	CONTENT	FROM	TO	SIZE	PUT IN	PULLED OUT
				8 5/8"	328	None

Describe in detail the manner in which the well was plugged, indicating where the mud fluid was placed and the method or methods used in introducing it into the hole. If cement or other plugs were used, state the character of same and depth placed, from _____ feet to _____ feet for each plug set.

Filled hole with Rotary Mud to 325 ft.
Set plug and run 20 sax cement with dump Bailer,
filled with mud to 40 ft. set plug and 10 sax
cement at the surface

RECEIVED
STATE CORPORATION COMMISSION
JUL 23 1953
CONSERVATION DIVISION
WICHITA, KANSAS

Name of Plugging Contractor M. B. Armer
Address Wichita, Kansas

STATE OF Kansas, COUNTY OF Sedgwick, ss.
L. C. Sponenberg (employee of owner) or (owner or operator) of the above-described well, being first duly sworn on oath, says: That I have knowledge of the facts, statements, and matters herein contained and the log of the above-described well as filed and that the same are true and correct. So help me God.

(Signature) L. C. Sponenberg
(Address) _____

SUBSCRIBED AND SWORN TO before me this 21 day of July, 19 53

My commission expires February 13, 1956. Rose Lusey Notary Public.

PLUGGING
FILE SEC 20 T 30 R 20W
BOOK PAGE 16 LINE 17

KANSAS WELL LOG BUREAU --- KANSAS GEOLOGICAL SOCIETY

508 EAST MURDOCK - WICHITA, KANSAS

COMPANY M. B. Armer

SEC. 20 T. 30S R. 20W

FARM Lorimor

NO. 1

LOC. NW NW NE

TOTAL DEPTH 5260'

CDMM. 6/17/53

COMP. 7/21/53

COUNTY Kiowa

SHOT OR TREATED
CONTRACTOR M. B. Armer
ISSUED

KANSAS			

CASING

20	10	
15	8	328'
12	6	
13	5	

ELEVATION 2277 K.B.

PRODUCTION D & A

FIGURES INDICATE BOTTOM OF FORMATIONS

Surface Clay & Sand	115
Shale & Shells "Sticky"	230
Red Bed, Shale & Shells	250
Red Bed & Shale	328
Red Bed	410
Anhydrite	455
Shale & Shells	625
Shale & Red Bed	777
Shale, Shells & Red Bed	895
Red Bed	1240
Anhydrite	1265
Shale & Shells	2295
Shale & Lime	4022
Lime	4288
Shale & Lime	4532
Lime	4625
Shale & Lime	4695
Lime	4776
Shale & Lime	4817
Lime	4860
Shale & Lime	4895
Lime	5009
Shale & Lime	5186
Shale, Lime & Chert	5221
Shale & Cherty Lime	5248
Lime & Chert	5260

FORMATION TOPS (R.B. Meas.)

HEEBNER	4279
BROWN LANSING	4469
LANSING-KANSAS CITY	4480
BASE OF K.C.	4845
MISSISSIPPI	5159

I hereby certify that this is a true and correct log of the above described well as shown by the drilling reports.

SEED
WICHITA COMMISSION
JUL 23 1953
CONSERVATION DIVISION
Wichita, Kansas

M. B. ARMER

By

[Handwritten Signature]

STATE OF KANSAS

COUNTY OF SEDGWICK

SS:

Subscribed and sworn to before me, a notary public, in and for said County and State this 22nd day of July, 1953.

[Handwritten Signature]
Notary Public

My Commission Expires: February 13, 1956.

PLUGGING
WELL SEC 20, 30 R 20W
LOC NW NW NE