

STATE OF KANSAS
STATE CORPORATION COMMISSION

Form CP-4


Give All Information Completely
Make Required Affidavit,
Mail or Deliver Report to:
Conservation Division
State Corporation Commission
212 No. Market
Wichita, Kansas

WELL PLUGGING RECORD

Kiowa County, Sec. 4 Twp. 30S Rge. (E) 19 (W)

Location as "NE/CNW%SW%" or footage from lines C NE SE
Lease Owner Anadarko Production Company
Lease Name Dean "B" Well No. 1
Office Address Box 351 Liberal, Kansas
Character of Well (completed as Oil, Gas or Dry Hole) Dry Hole
Date well completed 4/18 19 68
Application for plugging filed 4/18 19 68
Application for plugging approved 4/18 19 68
Plugging commenced 4/19 19 68
Plugging completed 4/19 19 68
Reason for abandonment of well or producing formation Dry Hole

NORTH

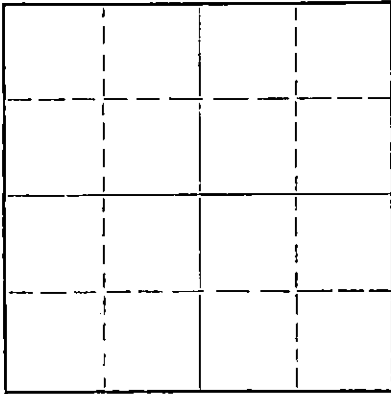

Locate well correctly on above
Section Plat

If a producing well is abandoned, date of last production 19
Was permission obtained from the Conservation Division or its agents before plugging was commenced?

Name of Conservation Agent who supervised plugging of this well Herman Justice Nickerson, Kansas 67561
Producing formation Depth to top Bottom Total Depth of Well 5230 Feet
Show depth and thickness of all water, oil and gas formations.

OIL, GAS OR WATER RECORDS

CASING RECORD

FORMATION	CONTENT	FROM	TO	SIZE	PUT IN	PULLED OUT
				8-5/8	427	None

Describe in detail the manner in which the well was plugged, indicating where the mud fluid was placed and the method or methods used in introducing it into the hole. If cement or other plugs were used, state the character of same and depth placed, from feet to feet for each plug set.

Spotted 35 sxs of cement @ 5150'
Filled hole with mud to 400'. Pushed rubber plug to 400'.
Formed bridge on top of plug.
Spotted 25 sacks of cement @ 400'.
Filled hole with mud to 30'.
Spotted 10 sacks of cement from 30' to 0'.
Plugged rat hole & mouse hole with 5 sacks of cement.
Completed @ 11:00 a.m. 4/19/68.

RECEIVED
STATE CORPORATION COMMISSION
APR 29 1968
CONSERVATION DIVISION
Wichita, Kansas

(If additional description is necessary, use BACK of this sheet)
Name of Plugging Contractor Garvey Drilling Company
Address Wichita, Kansas


STATE OF Kansas, COUNTY OF Seward, ss.
V. K. Downey (employee of owner) or (owner or operator) of the above-described

well, being first duly sworn on oath, says: That I have knowledge of the facts, statements, and matters herein contained and the log of the above-described well as filed and that the same are true and correct. So help me God.

V. K. Downey, Superintendent (Signature) Liberal Production Region
Box 351, Liberal, Kansas 67901 (Address)

Subscribed and Sworn to before me this 24th day of April, 19 68

J. W. Williams Notary Public.
My commission expires April 20, 1971

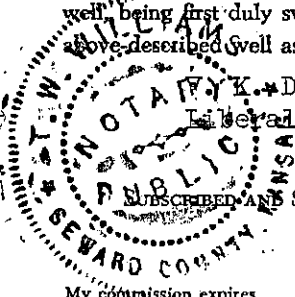

DRILLER'S LOG

WELL NAME: Dean "B" No. 1 ; COMPANY OPERATING: Anadarko Production Company
 ADDRESS of COMPANY: Box 351 Liberal, Kansas 67901

WELL LOCATION: C 1/4 NE 1/4 SE 1/4,
1980 ft. North of South line,
4620 ft. East of West line: Sec. 4, Twp. 30S, Rge. 19W, Kiowa County, Kansas

DRILLING STARTED 4/4, 19 68; DRILLING COMPLETED 4/18, 19 68
 WELL COMPLETED _____, 19____; WELL CONNECTED _____, 19____

ELEVATION: 2281.4' ft. Ground Level; CHARACTER OF WELL (Oil, Gas, or Dry Hole) Dry Hole

OIL OR GAS SANDS OR ZONES - PERFORATIONS - ACIDIZING AND FRACTURING INFORMATION					
Name	From	To	No. of Shots	Gallons Used	Kind Used

RECEIVED
 STATE CORPORATION COMMISSION
 APR 29 1968
 CONSERVATION DIVISION
 Wichita, Kansas

CASING RECORD

Size	Amount Set	Sacks of Cement	Amount Pulled
8-5/8	427	450	None

FORMATION RECORD

Formation	Top	Bottom	Formation	Top	Bottom
Surface & Shale	0	418	Lime	5089	5110
Anhydrite	418	428	Lime & Shale	5110	5140
Red Bed	428	1200	Miss. Lime & Chert	5140	5173
Shale & Shells	1200	1725	Lime	5173	5210
Shale	1725	2200	Lime & Shale	5210	5230
Shale & Lime	2200	4370	TOTAL DEPTH	5230	
Shale	4370	4420			
Lime	4420	4485			
Lime & Shale	4485	4586			
Lime	4586	4846			
Lime & Shale	4846	4924			
Lime	4924	4980			
Lime & Shale	4980	5089			

RESULTS of INITIAL PRODUCTION TEST: P & A 4/19/68