


STATE OF KANSAS  
STATE CORPORATION COMMISSION

Give All Information Completely  
Make Required Affidavit  
Mail or Deliver Report to:  
Conservation Division  
State Corporation Commission  
212 North Market, Insurance Bldg.  
Wichita, Kansas

WELL PLUGGING RECORD

NORTH

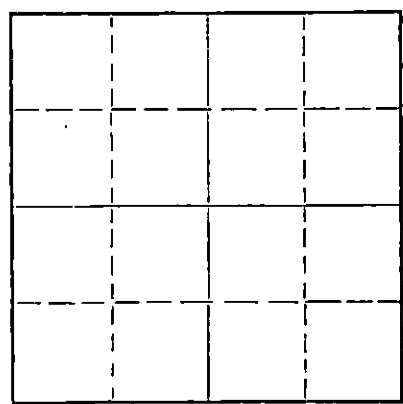

Locate well correctly on above  
Section Flat

Kiowa County. Sec. 1 Twp. 30S Rge. 19W (E)\_\_\_\_(W)  
Location as "NE/CNW&SW&" or footage from lines C SW NE  
Lease Owner Imperial Oil of Kansas, Inc.  
Lease Name Robbins Well No. 1  
Office Address 780 Fourth National Bldg., Wichita 2, Kansas  
Character of Well (completed as Oil, Gas or Dry Hole) Dry Hole  
Date well completed June 9 19 59  
Application for plugging filed June 9 19 59  
Application for plugging approved June 9 19 59  
Plugging commenced June 9 19 59  
Plugging completed June 9 19 59  
Reason for abandonment of well or producing formation No commercial quantities of oil found.

If a producing well is abandoned, date of last production \_\_\_\_\_ 19\_\_\_\_  
Was permission obtained from the Conservation Division or its agents before plugging was commenced? Yes.

Name of Conservation Agent who supervised plugging of this well Mr. W. L. Lackamp  
Producing formation \_\_\_\_\_ Depth to top \_\_\_\_\_ Bottom \_\_\_\_\_ Total Depth of Well 5091 Feet  
Show depth and thickness of all water, oil and gas formations.

OIL, GAS OR WATER RECORDS

CASING RECORD

FORMATION	CONTENT	FROM	TO	SIZE	PUT IN	PULLED OUT
				8-5/8"	381'	381'

Describe in detail the manner in which the well was plugged, indicating where the mud fluid was placed and the method or methods used in introducing it into the hole. If cement or other plugs were used, state the character of same and depth placed, from \_\_\_\_\_ feet to \_\_\_\_\_ feet for each plug set.

Bottom plug at 2375' - 1/2 sack hulls  
plug 20 sacks of cement. Mud to 38'.  
Top plug anchored - 1/2 sack hulls.  
Cement to bottom of cellar.

**RECEIVED**  
STATE CORPORATION COMMISSION  
AUG 17 1959  
CONSERVATION DIVISION  
Wichita, Kansas

(If additional description is necessary, use BACK of this sheet)  
Name of Plugging Contractor Pickrell Drilling Company  
Address Wichita, Kansas

STATE OF KANSAS COUNTY OF SEDGWICK, ss.  
Raymond L. Bacon (employee of owner) or (owner or operator) of the above-described well, being first duly sworn on oath, says: That I have knowledge of the facts, statements, and matters herein contained and the log of the above-described well as filed and that the same are true and correct. So help me God. **IMPERIAL OIL OF KANSAS, INC.**

(Signature) By: Raymond L. Bacon V-P  
780 Fourth National Bldg., Wichita 2, Kansas  
(Address)

SUBSCRIBED AND SWORN to before me this 13th day of August, 1959

My commission expires July 7, 1962  
Mona L. Latier  
Mona L. Latier Notary Public.

**PLUGGING**  
FILE SEC. 1 T. 30 R. 19W  
BOOK PAGE 59 LINE 90

ROTARY DRILLING LOG

COMPANY: Imperial Oil of Kansas, Inc.

Rotary Drilling Commenced 5/18/59

LOCATION: C SW NE Sec. 1-30s-19w  
Kiowa, County, Kansas  
Robbins #1

Rotary Drilling Completed 6/9/59

CONTRACTOR: PICKRELL DRILLING COMPANY  
Wichita, Kansas

CASING RECORD:

381' 8 5/8" surface pipe cemented with 275 sacks cement  
cement circulated.

D. & A.

LOG

(Figures indicate bottom of formation — measurements from top of rotary bushing.)

Top soil - clay	100'
Sand	115'
Gyp.	135'
Shale	350'
Red Rock	381'
Red Bed	520'
Anhydrite	560'
Red Bed	1240'
Anhydrite	1290'
Red bed and Green Shale	2060'
Shale and Lime	2275'
Brown and Green Shale and Lime	2440'
Lime and Shale	2530'
Lime	2645'
Green and Brown Shale	2714'
Lime and Shale	4032'
Lime	4160'
Lime and sand	4213'
Lime and shale	4400'
Lime	4997'
Mississippi	5091' T.D.

Circulate for samples

5000'  
5005'  
5015'  
5022'  
5038'  
5043'  
5050'  
5091'

**RECEIVED**  
STATE CORPORATION COMMISSION

AUG 17 1959

CONSERVATION DIVISION  
Wichita, Kansas

S.L.M. 2000' - OK  
3000' - OK  
4000' - OK

Slope Tests 500' - 0°  
1500' - 0°  
3500' - 0°  
4000' - 0°

The undersigned, C.W. Sebitt, Attorney-in-Fact for PICKRELL DRILLING COMPANY, hereby certifies in behalf of said Company, that the above is a true and correct log of the formation encountered in drilling the above well as reflected by the Daily Drilling Reports.

PICKRELL DRILLING COMPANY

STATE OF KANSAS }  
COUNTY OF SEDGWICK } ss.:

PLUGGING		By
FILE	SEC <u>1 T 30 R 19 W</u>	
BOOK	PAGE <u>59</u> LINE <u>40</u>	

*[Signature]*  
Attorney-in-Fact

On this 18 day of June, 1959, before me the undersigned, a Notary Public, in and for the County and State aforesaid, personally appeared C.W. Sebitt, to me known to be the identical person who subscribed the name of PICKRELL DRILLING COMPANY to the foregoing instrument as its Attorney-in-Fact and acknowledged to me that he executed the same as his free and voluntary act and deed, and as the free and voluntary act and deed of such company, for the uses and purposes therein set forth.

Given under my hand and seal of office the day and year last above written.

My commission expires: October 15, 1962

*[Signature]*  
Notary Public  
Judith L. Palmer