


WELL PLUGGING RECORD

Give All Information Completely
Make Required Affidavit
Mail or Deliver Report to:
Conservation Division
State Corporation Commission
211 No. Broadway
Wichita, Kansas

Kiowa County, Sec. 2 Twp. 30S Rge. 18W (E) (W)

Location as "NE/CNW/SW" or footage from lines C NE SW
Lease Owner K & E DRILLING, INC.
Lease Name Fincham Unit Well No. 1
Office Address 719 Union Center, Wichita, Kansas 67202
Character of Well (completed as Oil, Gas or Dry Hole) Dry Hole
Date well completed 1-25 19 67
Application for plugging filed 1-25 19 67
Application for plugging approved 1-25 19 67
Plugging commenced 1-25 19 67
Plugging completed 1-25 19 67
Reason for abandonment of well or producing formation Dry

NORTH

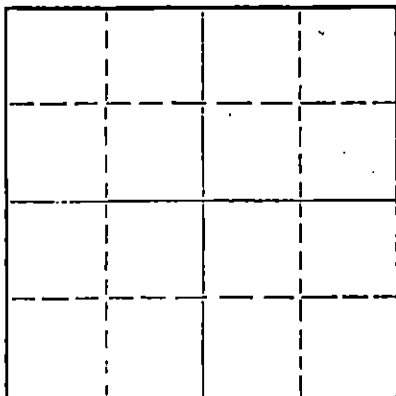

Locate well correctly on above Section Plat

If a producing well is abandoned, date of last production 19
Was permission obtained from the Conservation Division or its agents before plugging was commenced? Yes

Name of Conservation Agent who supervised plugging of this well Archie Elving, Pratt, Kansas
Producing formation _____ Depth to top _____ Bottom _____ Total Depth of Well 5525 Feet

Show depth and thickness of all water, oil and gas formations.

OIL, GAS OR WATER RECORDS

CASING RECORD

FORMATION	CONTENT	FROM	TO	SIZE	PUT IN	PULLED OUT
				8-5/8"	463'	0

Describe in detail the manner in which the well was plugged, indicating where the mud fluid was placed and the method or methods used in introducing it into the hole. If cement or other plugs were used, state the character of same and depth placed, from _____ feet to _____ feet for each plug set.

Heavy mud up to 400'. Set solid bridge & 25 sx. cement. Heavy mud up to 40' & solid bridge & solid bridge & 10 sx. cement up to base of cellar. 2 sx. cement in rat hole. Job completed at 5:00 P.M.

RECEIVED
STATE CORPORATION COMMISSION

FEB 2 1967

CONSERVATION DIVISION
Wichita, Kansas

2-3-67

(If additional description is necessary, use BACK of this sheet)

Name of Plugging Contractor K & E Drilling, Inc.
Address 719 Union Center Building, Wichita, Kansas 67202

STATE OF KANSAS, COUNTY OF SEDGWICK, ss.
H. W. Wilson (employee of owner) or (owner) of the above-described well, being first duly sworn on oath, says: That I have knowledge of the facts, statements, and matters herein contained and the log of the above-described well as filed and that the same are true and correct. So help me God.

(Signature) H. W. Wilson H. L. Wilson
719 Union Center, Wichita, Kansas
(Address)

SUBSCRIBED AND SWORN TO before me this 1st day of February, 1967

My commission expires 9-14-70

Judie K. Eby
Judie K. Eby Notary Public.

DRILLER'S WELL LOG

OPERATOR: K & E DRILLING, INC.
719 Union Center Building
Wichita, Kansas 67202

WELL NAME: #1 Fincham Unit
LOCATION: C NE SW Sec. 2-30S-18W
Kiowa County, Kansas

CONTRACTOR: **K & E DRILLING, INC.**
719 UNION CENTER BLDG.
WICHITA, KANSAS

COMMENCED: 1/3/67
COMPLETED: 1/25/67
ELEVATION: 2114' Gr; 2120' DF
2123' KB
PRODUCTION: D & A

CASING RECORD:
8-5/8" @ 463' w/300 sx.
ROTARY TOTAL DEPTH: 5525'

FORMATION RECORD

Depths shown indicate bottom of formations encountered.

Top Soil	40
Shale	385
Sand	420
Shale	455
Anhydrite	463
Anhydrite - Shale	492
Shale	1070
Shale & Shells	1970
Lime	2290
Lime & Shale	2410
Lime	3344
Lime & Shale	3515
Lime	5089
Lime - Chert	5114
Lime	5150
Lime - Chert	5170
Lime	5205
Lime - Chert	5295
Lime	5525

RECEIVED
 STATE CORPORATION COMMISSION
 FEB 8 1967
 CONSERVATION DIVISION
 WICHITA, KANSAS

CERTIFICATION

State of KANSAS }
County of SEDGWICK } ss:

I, H. L. Wilson, of K&E DRILLING, INC., upon oath state that the above and foregoing is a true and correct copy of the Driller's Log of the above named well.

H. L. Wilson
H. L. Wilson

Subscribed and sworn to before me this 1st day of February, 19 67.

Judie K. Eby
Judie K. Eby Notary Public.

My Commission expires: 9-14-70

