


STATE OF KANSAS
STATE CORPORATION COMMISSION

Form CP-4

Give All Information Completely
Make Required Affidavit
Mail or Deliver Report to:
Conservation Division
State Corporation Commission
P. O. Box 17027
Wichita, Kansas 67217
NORTH

WELL PLUGGING RECORD

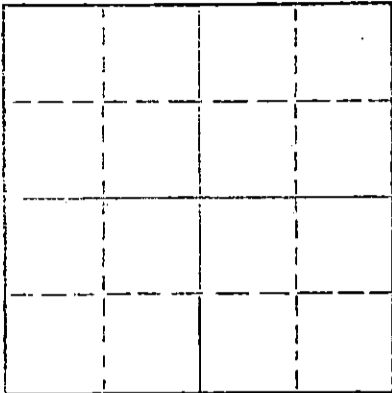

Locate well correctly on above
Section Plat

Stafford County, Sec. 19 Twp. 21 Rge. 13~~8~~ (E) (W)
Location as "NE/CNWSW" or footage from lines S/2 SW NE
Lease Owner J. K. Fortner
Lease Name Pundsack #1 Well No.
Office Address Ellinwood, Kansas 67526
Character of Well (completed as Oil, Gas or Dry Hole)
Date well completed 19
Application for plugging filed 19
Application for plugging approved 19
Plugging commenced 9/ 1/72 19
Plugging completed 9/ 1/72 19
Reason for abandonment of well or producing formation depleted.
If a producing well is abandoned, date of last production 19
Was permission obtained from the Conservation Division or its agents before plugging was commenced? yes

Name of Conservation Agent who supervised plugging of this well ~~YES~~ Biberstein
Producing formation Depth to top Bottom Total Depth of Well 3727' Feet
Show depth and thickness of all water, oil and gas formations.

OIL, GAS OR WATER RECORDS

CASING RECORD

FORMATION	CONTENT	FROM	TO	SIZE	PUT IN	PULLED OUT
				8-5/8	354	none
				5 1/2"	3724'	none

Describe in detail the manner in which the well was plugged, indicating where the mud fluid was placed and the method or methods used in introducing it into the hole. If cement or other plugs were used, state the character of same and depth placed, from feet to feet for each plug set.

Sanded hole to 3460' and dumped 5 sacks of cement. Set rock bridge at 560' and dumped 6 yards ready mix. Did not fill hole, dumped 3 more yards ready mix. Bailed hole to base of cellar.

PLUGGING COMPLETE.

RECEIVED
STATE CORPORATION COMMISSION
SEP 7 1972
CONSERVATION DIVISION
Wichita, Kansas

(If additional description is necessary, use BACK of this sheet)
Name of Plugging Contractor KNIGHT CASING PULLING CO., INC.
Address CHASE, KANSAS

STATE OF KANSAS COUNTY OF RICE, ss.
NOEL J. KNIGHT (employee of owner) or (owner or operator) of the above-described well, being first duly sworn on oath, says: That I have knowledge of the facts, statements, and matters herein contained and the log of the above-described well as filed and that the same are true and correct. So help me God.

(Signature) Noel Knight
CHASE, KANSAS
(Address)

SUBSCRIBED AND SWORN TO before me this 5th day of September, 1972

My commission expires
MARGARET MELCHER
NOTARY PUBLIC
Rice County, Kansas
My Commission Expires
Feb. 15, 1975

Margaret Melcher
Notary Public.

15.185.01711.0000

Pundak No. 1 Well

Sec. 19-21-13W, Stafford County, Kansas

5 1/2 Sur NE

Drilled for: Don Jones
Tulsa, Okla.

Drilled by: Mouser Drilling Co.

Drilling Commenced: October 2, 1953
Drilling Completed: October 16, 1953

Casing Record

8 5/8" 354' 2 1/2" Casing
5 1/2" 372 1/2' 1 1/2" 8rd thd Casing

<u>FORMATION</u>	<u>DEPTH</u>	<u>FORMATION</u>	<u>DEPTH</u>
Cellar	5		
Sand	200		
Blue shale	355		
Shale & shells	500		
Red bed & shale	800		
Anhydrite	860		
Shale	975		
Shale - red bed	1350		
Salt	1515		
Shale & shells	1740		
Lime	1850		
Lime - broken	1985		
Lime	2080		
Lime - broken	2165		
Lime & shale	2405		
Shale - broken lime	2545		
Shale & shells	2670		
Lime & shale	2875		
Lime	2955		
Lime & shale	2980		
Lime	3220		
Lime & shale	3375		
Lime	3675		
Chert	3723		
Lime	3727		
Total Depth	3727'		

RECEIVED
STATE CORPORATION COMMISSION
AUG 22 1972
CONSERVATION DIVISION
Wichita, Kansas

STATE OF KANSAS)
) ss.
COUNTY OF SEDGWICK)

I, the undersigned, being duly sworn on oath, state that the above and within statement is a true and correct record and log of the well drilled on the above described location to the best of my knowledge and belief.

Wm L. Roseworth Jr

Subscribed and sworn to before me this 21st day of October 1953.

Francis E. Hobbs

My Commission Expires:
March 18, 1954