


Give All Information Completely
Make Required Affidavit
Mail or Deliver Report to:
Conservation Division
State Corporation Commission
800 Bittling Building
Wichita, Kansas

WELL PLUGGING RECORD

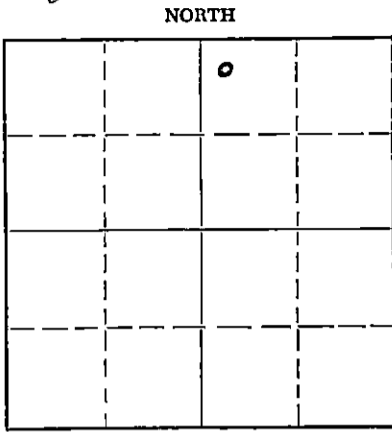

Locate well correctly on above Section Plat

Stafford County. Sec. 19 Twp. 21 Rge. 13 (K) W (W)
Location as "NE/CNW/SW" or footage from lines NW-NW-NE
Lease Owner PETROLEUM, Incorporated
Lease Name Hufford "B" Well No. 2
Office Address 311 East Third, Wichita 2, Kansas
Character of Well (completed as Oil, Gas or Dry Hole) Oil
Date well completed January 14, 1952
Application for plugging filed October 27, 1954
Application for plugging approved November 8, 1954
Plugging commenced November 9, 1954
Plugging completed November 15, 1954
Reason for abandonment of well or producing formation
Depletion of Producible Zones
If a producing well is abandoned, date of last production October 29, 1954
Was permission obtained from the Conservation Division or its agents before plugging was commenced? Yes

Name of Conservation Agent who supervised plugging of this well W.H. Horner
Producing formation Arbuckle Depth to top 3,691' Bottom -- Total Depth of Well 3,741' Feet
Show depth and thickness of all water, oil and gas formations.

OIL, GAS OR WATER RECORDS

CASING RECORD

FORMATION	CONTENT	FROM	TO	SIZE	PUT IN	PULLED OUT
<u>Arbuckle</u>	<u>Oil & Water</u>	<u>3,692'</u>	<u>3,702'</u>	<u>8-5/8"</u>	<u>367'</u>	<u>None</u>
				<u>5 1/2"</u>	<u>3,740'</u>	<u>3,025'</u>

Describe in detail the manner in which the well was plugged, indicating where the mud fluid was placed and the method or methods used in introducing it into the hole. If cement or other plugs were used, state the character of same and depth placed, from _____ feet to _____ feet for each plug set.

(Drilled cement out to 3,724')
Filled hole from 3,724' to 3,680' with crushed rock, and placed 5 sacks cement from 3,680' to 3,640'. Mudded up with heavy mud from 3,640' to 300'. Placed wooden plug at 300', and made a solid rock bridge from 300' to 295'. Filled with 20 sacks cement from 295' to 225'. Mudded up with heavy mud from 225' to 30'. set plug at 30' and filled hole to base of well cellar with 10 sacks cement.

11-30-54

(If additional description is necessary, use BACK of this sheet)
Name of Plugging Contractor Morgan Well Plugging Service
Address 102 West 18th Street, Hutchinson, Kansas

STATE OF Kansas, COUNTY OF Barton, ss.
Paul B. Shivel (employee of owner) or (MANAGER/OPERATOR) of the above-described well, being first duly sworn on oath, says: That I have knowledge of the facts, statements, and matters herein contained and the log of the above-described well as filed and that the same are true and correct. So help me God.

(Signature) Paul B. Shivel
Route 2, Great Bend, Kansas
(Address)

SUBSCRIBED AND SWORN to before me this 20th. day of November, 1954
Ray E. Andersson
Notary Public.

My commission expires November 21, 1957

PLUGGING
FILE SEC 19 T 21 R 13W
BOOK PAGE 23 LINE 34

DRILLERS LOG

#2 HUFFORD "B"

GARVEY OIL, LEASE OWNER

SEC. 19, TWP. 21S, RGE. 13W

ROCKET DRILLING COMPANY, CONTRACTOR

LOCATION: NW NW NE

DRILLING COMMENCED: 12-26-51

COUNTY: STAFFORD

DRILLING COMPLETED: 1-7-52

ROTARY TOTAL DEPTH: 3741'

CASING RECORD: 8-5/8" @ 367 w/378 SX
5-1/2" @ 3740 w/ 75 SX

ALL FIGURES BELOW INDICATE BOTTOM OF FORMATION:

SAND	0 TO 332	LIME	2095 TO 2210
SHALE	367	LIME & SHALE	2355
SHALE & RED SAND	811	SHALE & LIME	2510
ANHYDRITE	835	SHALE & SHELLS	2735
SHALE, SHELLS & SALT	1320	LIME & SHALE	2890
SHALE & SHELLS	1645	LIME	3265
SHALE & LIME	1810	SHALE	3342
LIME	1835	SHALE & LIME	3385
SAND	1852	LIME	3581
SHALE & LIME	1945	LIME & CHERT	3638
SHALE & LIME	2020	CHERT & SHALE	3680
SANDY SHALE	2037	SHALE & ARBUCKLE LIME	3695
SHALE & LIME	2095	ARBUCKLE LIME	3741 TD

STATE OF KANSAS)
) SS:
SEDGWICK COUNTY)

I HEREBY CERTIFY THAT TO THE BEST OF MY KNOWLEDGE AND BELIEF,
THE FOREGOING LOG IS TRUE AND CORRECT.

ROCKET DRILLING COMPANY

BY 

SUBSCRIBED AND SWORN TO BEFORE ME, A NOTARY PUBLIC, IN AND FOR
THE STATE AND COUNTY AFORESAID THIS 10TH DAY OF JANUARY, 1952.


NOTARY PUBLIC

MY COMMISSION EXPIRES: 12-3-55

PLUGGING
FILE SEC 19 T 21 R 13W
BOOK PAGE 23 LINE 34

RECORDED
INDEXED
CONSERVATION DIVISION
Wichita, Kansas