


WELL PLUGGING RECORD

Give All Information Completely
Make Required Affidavit
Mail or Deliver Report to:
Conservation Division
State Corporation Commission
800 Bittler Building
Wichita, Kansas

NORTH

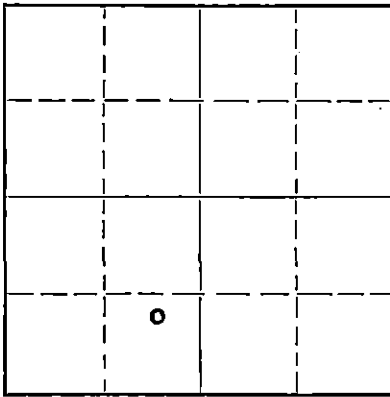

Locate well correctly on above
Section Flat

Stafford County. Sec. 19 Twp. 21 Rge. 13 (E) W (W)
Location as "NE/CNW $\frac{1}{4}$ SW $\frac{1}{4}$ " or footage from lines C N/2, SE/4, SW/4
Lease Owner Stanolind Oil and Gas Company
Lease Name Otto Pundsack Well No. 2
Office Address Box 1654, Oklahoma City, Oklahoma
Character of Well (completed as Oil, Gas or Dry Hole) Dry Hole
Date well completed 11-1-19 51
Application for plugging filed 11-8-19 51
Application for plugging approved approval by telephone 11-3-19 51
Plugging commenced 11-3-19 51
Plugging completed 11-3-19 51
Reason for abandonment of well or producing formation formations dry

If a producing well is abandoned, date of last production 19...
Was permission obtained from the Conservation Division or its agents before plugging was commenced? Yes

Name of Conservation Agent who supervised plugging of this well C. D. Stough
Producing formation None Depth to top Bottom Total Depth of Well Feet
Show depth and thickness of all water, oil and gas formations.

OIL, GAS OR WATER RECORDS

CASING RECORD

Formation	Content	From	To	Size	Put In	Pulled Out
Lansing - K.C.	Dry	3389	3721			
Simpson	"	3721	3767			
Arbuckle	"	3767	3875			

Describe in detail the manner in which the well was plugged, indicating where the mud fluid was placed and the method or methods used in introducing it into the hole. If cement or other plugs were used, state the character of same and depth placed, from feet to feet for each plug set.

Hvy. mud 3875 - 270
plug 270 - 268
15 sx cement 268 - 223
hvy. mud 223 - 30
plug 30 - 28
10 sx cement 28 - bottom of cellar

(If additional description is necessary, use BACK of this sheet)

Correspondence regarding this well should be addressed to G. A. Younie
Address Box 7, Ellinwood, Kansas

STATE OF Kansas, COUNTY OF Barton, ss.

G. A. Younie (employee of owner) or (owner or operator) of the above-described well, being first duly sworn on oath, says: That I have knowledge of the facts, statements, and matters herein contained and the log of the above-described well as filed and that the same are true and correct. So help me God

(Signature) *G. A. Younie*
Box 7, Ellinwood, Kansas
(Address)

SUBSCRIBED AND SWORN to before me this 8th day of November, 19 51.

My commission expires May 2, 1955

23-5091-S 8-50-10M

PLUGGING
FILE REC-197-21 R-130
BOOK PAGE 14 LINE 23

NOV 10 1951 11-10-51
CONSERVATION DIVISION
Wichita, Kansas

Notary Public.

FORMATION RECORD

DESCRIBE EACH FORMATION DRILLED. INDICATE THICKNESS, CONTENT AND WHETHER DRY, OR OIL, GAS, OR WATER BEARING.

FORMATION	TOP	BOTTOM	FORMATION	TOP	BOTTOM
Sand	0	160			
Sand and clay	160	240			
Sand	240	315			
Shale and sand	315	515			
Red bed	515	670			
Shale and shells	670	812			
Anhydrite	812	840			
Red bed & shale	840	1565			
Shale and shells	1565	1860			
Lime	1860	1960			
Lime and shale	1960	2675			
Shale	2675	2895			
Shale and lime	2895	3135			
Lime	3135	3189			
Shale and lime	3189	3240			
Lime	3240	3265			
Lime and shale	3265	3315			
Lime	3315	3389			
Lansing - K.C. Top	3389				
Lime	3389	3635			
Conglomerite	3635	3721			
Simpson - Top	3721				
Lime	3721	3750			
Waxy shale	3750	3759			
Waxy shale & dolomite	3759	3767			
Arbuckle - Top	3767				
Dolomite Asphalt Residue	3767	3771			
Dolomite, no shows	3771	3875			
Total Depth:					
By Schlumberger		3875			
By Rotary Drill		3875			

Well completed as dry hole and plugged 11-3-51

PLUGGING
 FILE SEC. 19-T 21-R 134
 NOY NOV 24 1951 23

