


STATE OF KANSAS
STATE CORPORATION COMMISSION

WELL PLUGGING RECORD

Give All Information Completely
Make Required Affidavit
Mail or Deliver Report to:
Conservation Division
State Corporation Commission
800 Bitting Building
Wichita, Kansas

Stafford County. Sec. 19 Twp. 21 Rge. 13 (E) (W)
Location as "NE/CNW $\frac{1}{4}$ SW $\frac{1}{4}$ " or footage from lines SE NE NE
Lease Owner Petroleum, Inc.
Lease Name Hufford 'B' Well No. 1
Office Address 100 Derby Building, Wichita, Kansas
Character of Well (completed as Oil, Gas or Dry Hole) Dry Hole
Date well completed October 29, 1950
Application for plugging filed November 2, 1950
Application for plugging approved October 31, 1950
Plugging commenced October 29, 1950
Plugging completed October 29, 1950
Reason for abandonment of well or producing formation Dry Hole

NORTH

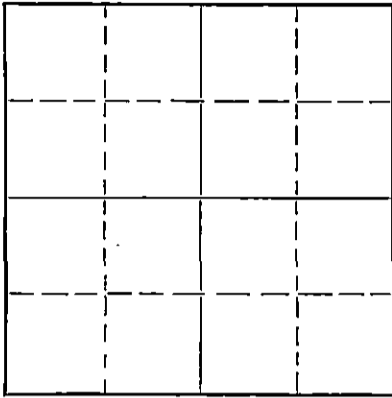

Locate well correctly on above
Section Flat

If a producing well is abandoned, date of last production 19...
Was permission obtained from the Conservation Division or its agents before plugging was com-
menced? Yes

Name of Conservation Agent who supervised plugging of this well Mr. C. D. Stough
Producing formation Depth to top Bottom Total Depth of Well 3790 Feet
Show depth and thickness of all water, oil and gas formations.

OIL, GAS OR WATER RECORDS

CASING RECORD

Formation	Content	From	To	Size	Put In	Pulled Out
				8 5/8"	217'	None

Describe in detail the manner in which the well was plugged, indicating where the mud fluid was placed and the method or methods used in introducing it into the hole. If cement or other plugs were used, state the character of same and depth placed, from...feet to...feet for each plug set.

Filled hole with mud to 210'. Placed
wooden plug at 210' and cemented with 15
sax cement. Filled hole with heavy mud
to 30'. Placed plug at 30' and cemented
to surface.

11-3-50
RECEIVED
STATE CORPORATION COMMISSION
NOV - 3 1950

(If additional description is necessary, use BACK of this sheet)
Correspondence regarding this well should be addressed to Petroleum, Inc. Wichita, Kansas
Address 100 Derby Building, Wichita, Kansas

STATE OF KANSAS, COUNTY OF SEDGWICK, ss.
Woody W. Fisher (employee of owner) of (owner or operator) of the above-described well,
being first duly sworn on oath, says: That I have knowledge of the facts, statements, and matters herein contained and the log of the above-
described well as filed and that the same are true and correct. So help me God.

(Signature) Woody W Fisher
100 Derby Building, Wichita, Kans.
(Address)

SUBSCRIBED AND SWORN to before me this 2nd day of November, 1950

Charlotte Hedman
Notary Public.

My commission expires October 13, 1954

23-2278-5 4-50-10M
PLUGGING
FILE SEC. 19-T 21-R (30)
BOOK PAGE 39 LINE 37

