

STATE OF KANSAS
STATE CORPORATION COMMISSION

WELL PLUGGING RECORD


Give All Information Completely
Make Required Affidavit
Mail or Deliver Report to:
Conservation Division
State Corporation Commission
800 Bittling Building
Wichita, Kansas

OR
FORMATION PLUGGING RECORD

Strike out upper line
when reporting plug-
ging off formations.

Stafford County. Sec. 19 Twp. 21 Rge. 13 (W)

Location as "NE $\frac{1}{4}$ NW $\frac{1}{4}$ SW $\frac{1}{4}$ " or footage from lines NW NW SW
Lease Owner Graham-Messman-Rinehart Oil Company
Lease Name Pundsack Well No. 1
Office Address 204 No. Market, Wichita 2, Kans.
Character of Well (completed as Oil, Gas or Dry Hole) dry
Date well completed January 15 19 51
Application for plugging filed February 9 19 "
Application for plugging approved January 30 19 "
Plugging commenced January 24 19 "
Plugging completed January 25 19 "
Reason for abandonment of well or producing formation dry

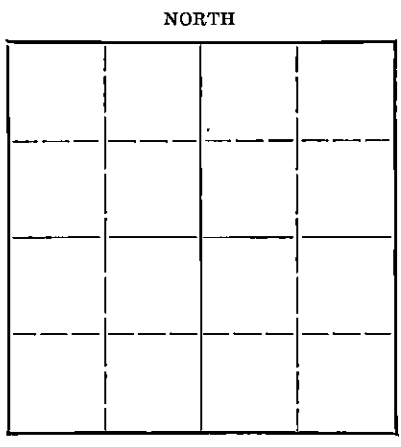

Locate well correctly on above
Section Plat

If a producing well is abandoned, date of last production 19
Was permission obtained from the Conservation Division or its agents before plugging was com-
menced? yes

Name of Conservation Agent who supervised plugging of this well C. D. Stough
Producing formation Depth to top Bottom Total Depth of Well Feet
Show depth and thickness of all water, oil and gas formations.

OIL, GAS OR WATER RECORDS

CASING RECORD

Formation	Content	From	To	Size	Put In	Pulled Out
				8 5/8	189	none
				5 1/2	3721	1557

Describe in detail the manner in which the well was plugged, indicating where the mud fluid was placed and the method or methods used in introducing it into the hold. If cement or other plugs were used, state the character of same and depth placed, from feet to feet for each plug set.

3 saks cement & 2 sacks Cal Seal at 3732,
Baker plug at 3700, fill with gravel
to 3491, 5 sacks cement to 3460 mud
to 195, bridge at 195, 12 feet rock 20 sacks
cement fill to top, 4 sacks cement in top
of surface casing.

RECEIVED
STATE CORPORATION COMMISSION
FEB 10 1951
CONSERVATION DIVISION
Wichita, Kansas

2-10-51

(If additional description is necessary, use BACK of this sheet)

Correspondence regarding this well should be addressed to Graham-Messman-Rinehart Oil Co.
Address 204 No. Market Street, Wichita 2, Kansas.

STATE OF KANSAS, COUNTY OF SEDGWICK, ss.
J. A. GILLILAND (employee of owner) of the above-described well,

being first duly sworn on oath, says: That I have knowledge of the facts, statements, and matters herein contained and the log of the above-described well as filed and that the same are true and correct. So help me God.

(Signature) J. A. Gilliland

204 N. Mkt., Wichita 2, Kans.
(Address)

SUBSCRIBED AND SWORN TO before me this 9th day of February, 1951.

Heraldine F. Ward
Notary Public.

My commission expires 9-13-54

PLUGGING
FILE SEC 19 T 21 R 12
BOOK PAGE 58 LINE 44

PUNDSACK # 1

WELL RECORD

Location: NW NW SW 19-21-13W Stafford Co., Kans.	Commenced: 12-26-50
Operator: G-M-R Oil Co. 204 N. Mkt. Wichita, Kans.	Completed: 1-11-51
Casing Record:	Elevation: 1929 D.F.
	Production: D & A
	Contractor: G-M-R Oil Co.

LOG

(Figures indicate
bottom of formation)

Sand	70	
Clay	138	
Sandstone	144	
Shale & Shells	818	
Anhydrite	850	
Shale & Shells	1100	
Shale & Salt	1575	Brown Lansing 3367 (-1435)
Shale & Lime	1720	White Lansing 3378 (-1446)
Lime & Shale	2115	Conglomerate 3627 (-1695)
Shale & Shells	2380	Viola Chert 3635 (-1703)
Shale & Lime	2510	
Lime & Shale	2615	
Shale & Lime	2680	
Shale & Lime	2795	
Lime & Shale	3030	
Lime	3307	
Lime & Shale	3368	
Lime	3660	
Simpson	3722	
T.D.	3722	

The undersigned, Graham-Messman-Rinehart Oil Company, hereby certifies that the above log is a true and correct log of the formation encountered in drilling the above well as reflected by the Daily Drilling Reports.

GRAHAM-MESSMAN-RINEHART OIL COMPANY

BY J.A. Gilliland
J.A. Gilliland, Office Mgr.

Subscribed and sworn to before me this 24th day of January, 1951.

Geraldine F. Ward
Notary Public
My Commission expires: 9-13-54

RECEIVED
STATE CORPORATION COMMISSION
FEB 10 1951
CONSERVATION DIVISION
Wichita, Kansas

cc: Kansas Well Log Bureau

PLUGGING
FILE SEC. 19 T. 21 R. 13
BOOK PAGE 58 LINE 44