


WELL PLUGGING RECORD

Give All Information Completely
Make Required Affidavit
Mail or Deliver Report to:
Conservation Division,
State Corporation Commission
211 No. Broadway
Wichita, Kansas

Stafford County. Sec. 19 Twp. 21 Rge. 13W (R) (W)
Location as "NE/CNW/SW" or footage from lines SE SE NE
Lease Owner Thunderbird Drilling Co., Inc.
Lease Name Pundsack Well No. A-2
Office Address 712 Union Center Wichita, Kansas
Character of Well (completed as Oil, Gas or Dry Hole) depleted-oil
Date well completed _____ 19____
Application for plugging filed _____ 19____
Application for plugging approved _____ 19____
Plugging commenced _____ 19____
Plugging completed July 18, 1960
Reason for abandonment of well or producing formation _____

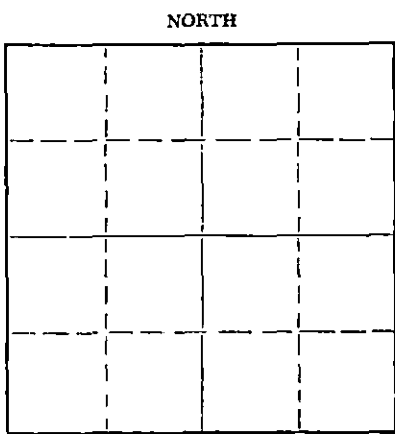

Locate well correctly on above
Section Plat

If a producing well is abandoned, date of last production _____ 19____
Was permission obtained from the Conservation Division or its agents before plugging was commenced? Yes

Name of Conservation Agent who supervised plugging of this well Frank Broadfoot
Producing formation _____ Depth to top _____ Bottom _____ Total Depth of Well 3781 Feet
Show depth and thickness of all water, oil and gas formations.

OIL, GAS OR WATER RECORDS

CASING RECORD

FORMATION	CONTENT	FROM	TO	SIZE	PUT IN	PULLED OUT

Describe in detail the manner in which the well was plugged, indicating where the mud fluid was placed and the method or methods used in introducing it into the hole. If cement or other plugs were used, state the character of same and depth placed, from _____ feet to _____ feet for each plug set.

8 5/8" - 345' - 5 1/2" - 3780' - Top Perf - 3461'
Sanded bottom of hole back to 3450' with 5 sacks
cement with bailer. Pulled 1800' 5 1/2" squeezed
with 10 sacks Gel Mud - 70 sacks cement to base
of cellar.

RECEIVED
STATE CORPORATION COMMISSION

JUN 22 1965

6-22-65

CONSERVATION DIVISION
Wichita, Kansas

(If additional description is necessary, use BACK of this sheet)

Name of Plugging Contractor Ace Pipe Pulling
Address Great Bend, Kansas

STATE OF KANSAS, COUNTY OF SEDGWICK, ss.
Charles W. Aikins, Jr. (employee of owner) or (owner or operator) of the above-described well, being first duly sworn on oath, says: That I have knowledge of the facts, statements, and matters herein contained and the log of the above-described well as filed and that the same are true and correct. So help me God.

(Signature) [Signature]
712 Union Center, Wichita, Kansas
(Address)

SUBSCRIBED AND SWORN to before me this 21st day of June, 1965

My commission expires 8-24-68 Cara Lou Smith Notary Public.

PUNDACK "A" 2

LOCATION: Q SE SE NE Commenced: 4-18-54
 Sec. 19, 21.S, 13.W Completed: 4-30-54
 Stafford County, Kansas

CONTRACTOR: Thunderbird Drilling, Inc.
 1311 Union National Bank Bldg.
 Wichita 2, Kansas

SURFACE CASING: 326' 8 5/8" - 225 sacks cement
 and 2 sacks Calcium Chloride

OIL STRING: 3780' 5 1/2" Cemented with 125 Sacks

LOG

0 - 150	Sand and Shale
150 - 225	Shale and Shells
225 - 300	Sand
300 - 430	Shale and Shells
430 - 645	Shale and Red Bed
645 - 806	Red Bed
806 - 825	Anhydrite
825 - 1250	Shale and Shells
1250 - 1330	Salt
1330 - 1650	Shale and Shells
1650 - 1700	Broken Lime
1700 - 1860	Lime and Shale
1860 - 2165	Broken Lime
2165 - 2400	Lime and Shale
2400 - 2655	Shale and Shells
2655 - 3060	Shale and Lime
3060 - 3180	Lime
3180 - 3230	Broken Lime
3230 - 3375	Lime and Shale
3375 - 3620	Lime
3620 - 3677	Lime and Chert
3677 - 3730	Lime and Shale
3730 - 3755	Arbuckle Lime
3755 - 3780	Lime
3780	Total Depth

RECEIVED
 STATE CORPORATION COMMISSION

JUN 22 1955

CONSERVATION DIVISION
 Wichita, Kansas

The undersigned, J. W. Owen, an officer of Thunderbird Drilling, Inc., hereby certifies that the above is a true and correct log of the formations encountered in drilling the Pundack "A" 2 well as shown in the daily drilling reports.

THUNDERBIRD DRILLING, INC.

 J. W. Owen

Subscribed and sworn to before
 me this 4th day of May, 1954.

 Notary Public

My Commission Expires: August 25, 1956.