


WELL PLUGGING RECORD

Give All Information Completely
Make Required Affidavit
Mail or Deliver Report to:
Conservation Division
State Corporation Commission
212 North Market, Insurance Bldg.
Wichita, Kansas

Stafford County, Sec. 19 Twp. 21 Rge. 13 (E) (W)
Location as "NE/CNWxSWx" or footage from lines SW SE NE
Lease Owner Thunderbird Drilling Inc.
Lease Name Rundsack "A" Well No. 1
Office Address 712 Union Center Bldg. Wichita, Kansas
Character of Well (completed as Oil, Gas or Dry Hole) oil drxx
Date well completed 19
Application for plugging filed 5-10-60 19
Application for plugging approved 5-11-60 19
Plugging commenced 5-11-60 19
Plugging completed 5-15-60 19
Reason for abandonment of well or producing formation dry

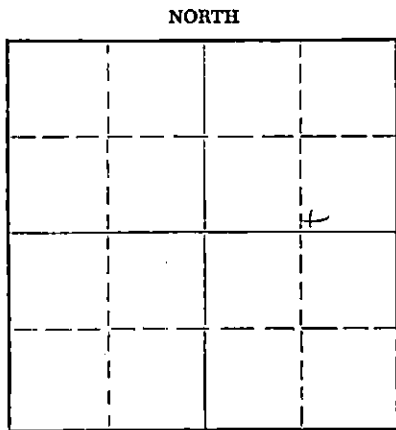

Locate well correctly on above Section Plat

If a producing well is abandoned, date of last production 19
Was permission obtained from the Conservation Division or its agents before plugging was commenced? yes

Name of Conservation Agent who supervised plugging of this well Frank Broadfoot
Producing formation _____ Depth to top _____ Bottom _____ Total Depth of Well 3778 Feet
Show depth and thickness of all water, oil and gas formations.

OIL, GAS OR WATER RECORDS

CASING RECORD

FORMATION	CONTENT	FROM	TO	SIZE	PUT IN	PULLED OUT

Describe in detail the manner in which the well was plugged, indicating where the mud fluid was placed and the method or methods used in introducing it into the hole. If cement or other plugs were used, state the character of same and depth placed, from _____ feet to _____ feet for each plug set.

Filled back with sand to 3725', mixed and run 5 sacks cement with dump bailer
Pumped 40 sacks mud plug and 70 sacks cement, filled surface casing 210' with cement
cement coated approx. 30' in 8 5/8 surface casing.

RECEIVED
STATE CORPORATION COMMISSION

MAY 19 1960

CONSERVATION DIVISION
Wichita, Kansas

5-19-60

(If additional description is necessary, use BACK of this sheet)

Name of Plugging Contractor Southwest Casing Pulling Co., Inc.
Address Box 361, Great Bend, Kansas

STATE OF Kansas, COUNTY OF Barton, ss.
Southwest Casing Pulling Co., Inc. (employee of owner) or (owner or operator) of the above-described well, being first duly sworn on oath, says: That I have knowledge of the facts, statements, and matters herein contained and the log of the above-described well as filed and that the same are true and correct. So help me God.

(Signature) Roy L. Myers Roy L. Myers
Box 361, Great Bend, Kansas Sec. Treas.
(Address)

SUBSCRIBED AND SWORN TO before me this 18 day of May, 19 60

Granita Myers
Notary Public.

My commission expires December 18, 1962

15.185.01713.0000

Pundsack No. 1A Well

Sec. 19-21-13W, Stafford County, Kansas

Drilled for: Don Jones
Tulsa, Okla.

Drilled by: Mouser Drilling Co.

Drilling Commenced: November 26, 1953
Drilling Completed: December 9, 1953

Casing Record:

8 5/8" 349' 24# Casing
5 1/2" 3778' 14# 8rd thd Casing

<u>FORMATION</u>	<u>DEPTH</u>
Cellar	4
Sand	160
Blue shale	350
Shale & red bed	806
Anhydrite	835
Shale & shells	1030
Shale & shells	1360
Salt	1495
Shale & shells	1710
Shale & lime	1813
Lime	1995
Shale & lime	2750
Lime	3230
Lime & shale	3355
Lime	3615
Lime & chert	3676
Lime	3778
Total Depth	3778'

FORMATION DEPTH

RECEIVED
STATE CORPORATION COMMISSION

JUN 22 1965

CONSERVATION DIVISION
Wichita, Kansas

STATE OF KANSAS)
) SS.
COUNTY OF SEDGWICK)

I, the undersigned, being duly sworn on oath, state that the above and within statement is a true and correct record and log of the well drilled on the above described location to the best of my knowledge and belief.

W. L. Ainsworth, Jr.

Subscribed and sworn to before me this 14th day of December 1953.

James K. Webber

My commission expires:

March 18, 1956