

15.185.20746.0000

STATE OF KANSAS
STATE CORPORATION COMMISSION


WELL PLUGGING RECORD

Give All Information Completely
Make Required Affidavit

Mail or Deliver Report to
Conservation Division
State Corporation Comm.
245 North Water
Wichita, KS 67202

Stafford County, Sec. 19 Twp. 21 Rge. 13 ~~W~~
Location as "NE/CNW $\frac{1}{4}$ /SW $\frac{1}{4}$ " or footage from lines
NE NE NW

Lease Owner ICER ADDIS
Lease Name Pundsack Well No. 1
Office Address P.O. Drawer 8038 - Wichita, KS. 67208
Character of Well (Completed as Oil, Gas or Dry Hole)

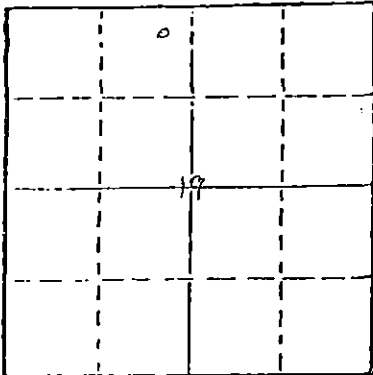

Locate well correctly on above
Section Plat

Dry Hole
Date Well completed Feb. 22, 1978
Application for plugging filed Feb. 22, 1978
Application for plugging approved Feb. 22, 1978
Plugging commenced Feb. 22, 1978
Plugging completed Feb 22, 1978
Reason for abandonment of well or producing formation

If a producing well is abandoned, date of last production 19

Was permission obtained from the Conservation Division or its agents before plugging was commenced? yes

Name of Conservation Agent who supervised plugging of this well Bill Owen
Producing formation Depth to top Bottom Total Depth of Well 3719

Show depth and thickness of all water, oil and gas formations.

OIL, GAS OR WATER RECORDS

CASING RECORD

FORMATION	CONTENT	FROM	TO	SIZE	PUT IN	PULLED OUT

Describe in detail the manner in which the well was plugged, indicating where the mud fluid was placed and the method or methods used in introducing it into the hold. If cement or other plugs were used, state the character of same and depth placed, from feet to feet for each plug set.

Bottom Plug @ 540' with 40 sacks cement thru drill pipe.
Middle Plug @ 340' with 35 sacks cement thru drill pipe
Top Plug @ 40' with $\frac{1}{2}$ sack hulls and 12 sacks cement.
3 sacks in rat hole

RECEIVED
STATE CORPORATION COMMISSION

FEB 28 1978

CONSERVATION DIVISION
Wichita, Kansas

(If additional description is necessary, use BACK of this sheet)

Name of Plugging Contractor Duke Drilling Co., Inc. Great Bend, KS. 67530

STATE OF Kansas COUNTY OF Barton, ss.

Leonard Williamson (employee of owner) or (owner or operator) of the above-described well, being first duly sworn on oath, says: That I have knowledge of the facts, statements, and matters herein contained and the log of the above-described well as filed and that the same are true and correct. So help me God.

(Signature) Leonard Williamson
Box 823 - Great Bend, KS. 67530
(Address)

SUBSCRIBED AND SWORN TO before me this 27 day of February, 19 78

Dorothy M. Hague
Notary Public.

My commission expires April 11, 1978

DRILLERS' WELL LOG

15.185.20746.0000

DATE COMMENCED: February 16, 1978
DATE COMPLETED: February 22, 1978

Icer Addis
PUNDSACK #1
NE NE NW
Sec.19-T21S-R13W
Stafford County, Kansas

0 - 70' Sandy Clay
70 - 225' Shale
225 - 330' Sand
330 - 809' Shale, Red Bed & Sand Streaks
809 - 830' Anhydrite
830 - 1630' Red Bed & Shale
1630 - 1750' Shale & lime Streaks
1750 - 2969' Lime & Shale
2969 - 3231' Lime
3231 - 3235' Shale
3235 - 3258' Lime & Shale
3258 - 3271' Lime
3271 - 3354' Shale
3354 - 3365' Lime & Shale
3365 - 3590' Lime
3590 - 3600' Lime & Shale
3600 - 3617' Lime, Chert, Shale, Congl.
3617 - 3672' Chert
3672 - 3619' Shale, Lime
3619' RTD

Elevation: 1919 K.B.

FORMATION DATA

Anhydrite 809
Topeka 2969
Heebner 3231
Toronto 3258
Douglas 3271
Br. Lime 3354
Kansas City 3365
Base K.C. 3590
Conglomerate 3600
Viola 3617
Simpson 3672
RTD 3719

RECEIVED
STATE CORPORATION COMMISSION
FEB 28 1978
CONSERVATION DIVISION
Wichita, Kansas

SURFACE PIPE: Set used
8-5/8" pipe at 341' with
325 sacks 50/50 pozmix,
2% Gel, 3% ch.c.h.

A F F I D A V I T

State of Kansas
County of Barton) ss.

Leonard Williamson, of lawful age, does swear and state that the facts
and statements herein contained are true and correct to the best of his knowledge.

Leonard Williamson

Subscribed and sworn to before me this 27 day of February 1978.

My Comm. Expires:
April 11, 1978

Rosethy M. Hague
Notary Public