


STATE OF KANSAS
STATE CORPORATION COMMISSION

Give All Information Completely
Make Required Affidavit
Mail or Deliver Report to:
Conservation Division
State Corporation Commission
212 No. Market
Wichita, Kansas

WELL PLUGGING RECORD

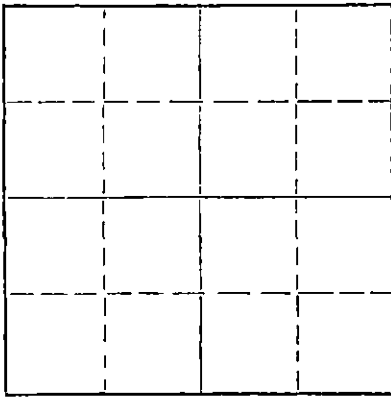

Locate well correctly on above
Section Plat

Stafford County, Sec. 19 Twp. 21 Rge. 13 (E) (W)
Location as "NE/CNW%SW%" or footage from lines Sw Sw Se
Lease Owner Specter Pipe & Supply, Inc.
Lease Name Herman Schulz Well No. 1
Office Address Russell, Kansas
Character of Well (completed as Oil, Gas or Dry Hole) Oil
Date well completed 6-6-48 19
Application for plugging filed March 5, 1968 19
Application for plugging approved March 8, 1968 19
Plugging commenced 4/16 19.68
Plugging completed 4/20 19.68
Reason for abandonment of well or producing formation Dry

If a producing well is abandoned, date of last production 19
Was permission obtained from the Conservation Division or its agents before plugging was commenced? Yes

Name of Conservation Agent who supervised plugging of this well Ralph Warren
Producing formation Kansas City Depth to top 3302 Bottom 3647 Total Depth of Well 3737 Feet
Show depth and thickness of all water, oil and gas formations.

OIL, GAS OR WATER RECORDS

CASING RECORD

FORMATION	CONTENT	FROM	TO	SIZE	PUT IN	PULLED OUT
				8 5/8" OD	822 ft.	none
				5 1/2" OD	3732 ft.	2804 ft.

Describe in detail the manner in which the well was plugged, indicating where the mud fluid was placed and the method or methods used in introducing it into the hole. If cement or other plugs were used, state the character of same and depth placed, from feet to feet for each plug set.

Plugged Back to 3400' with Sand,
Dumped 5 sacks cement.
Set 10' Rock Bridge at 300'
Mudded to 40'
Set 10' rock bridge.
Topped with 10 sacks cement.

RECEIVED
STATE CORPORATION COMMISSION
APR 26 1968
CONSERVATION DIVISION
Wichita, Kansas

(If additional description is necessary, use BACK of this sheet)

Name of Plugging Contractor
Address

STATE OF Kansas, COUNTY OF Russell, ss.
Specter Pipe & Supply, Inc. (employee of owner) or (owner or operator) of the above-described well, being first duly sworn on oath, says: That I have knowledge of the facts, statements, and matters herein contained and the log of the above-described well as filed and that the same are true and correct. So help me God.

(Signature) [Signature]
Russell, Kansas (Address)

SUBSCRIBED AND SWORN to before me this 24th day of April, 1968

Wilma M. Lindahl
Notary Public.

My commission expires May 21, 1971

WELL LOG BUREAU KANSAS GEOLOGICAL SOCIETY
412 Union National Bldg. Wichita, Kansas

15.195-10624.0000


COPY

Company - SKELLY OIL COMPANY
Farm - Herman Schulz No. 1

SEC. 19 T. 21 S. 13W
SW SW SE
330' fsl & 330' fwl SE $\frac{1}{4}$

Total Depth. 3737'
Comm. 5-13-48 Comp. 10-6-48
Shot or Treated. Acidized
Contractor. Claude Wentworth Drilling Co.
Issued. 8-7-48

County. Stafford
KANSAS

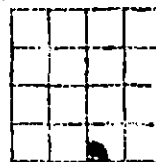

Elevation. _____

Production. Pot. 180 BO

CASING:

9" 822' Cem. w/500 sx
5" 3732' Cem. w/135 sx

Figures Indicate Bottom of Formations.

surface soil & sand	0-157
shale & shells	410
sand	550
shale & shells	811
anhydrite	822
anhydrite	850
shale & shells & red bed	1082
shale & shells	1360
salt	1580
shale	1800
lime	1905
shale & lime	2195
lime	2250
shale & shells	2555
shale & shells	2735
shale	2660
shale & lime	3170
lime	3260
lime & shale	3430
lime	3595
lime & shale	3648
chert	3669
shale & chert	3689
sand & shaley sd	3706
shale sd	3730
finely xln dolomite	3733
brwn coarsely xln dol.	3735
same w/little green shale	3737
Total Depth	

Tops:

Lansing Lime	3382
Viola Lime	3648
Simons Sand	3679
Hubbucke Linc	3730

3490-3506 Bor. & oil saturated
3648-3669 sh. por. & oil sat.
3689-3706 sh. por. & oil stain
3730-3733 sh. por. & oil stained
3733-3737 fair por. & sat. 40 BO
in 14 hours.

Acid. w/500 gallons 6-7-48 3732-3737

RECEIVED
STATE CORPORATION COMMISSION
MAR 8 - 1968
CONSERVATION DIVISION
Wichita, Kansas