


WELL PLUGGING RECORD

Give All Information Completely
Make Required Affidavit
Mail or Deliver Report to:
Conservation Division
State Corporation Commission
800 Bitting Building
Wichita, Kansas

NORTH

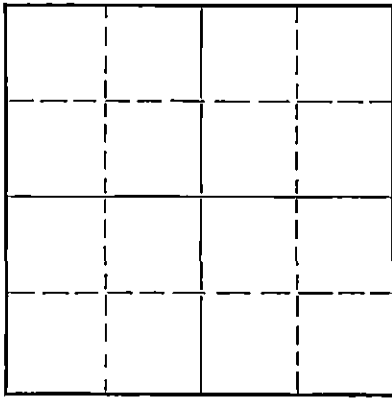

Locate well correctly on above
Section Flat

Stafford County. Sec. 10 Twp. 21 Rge. 13 (W)
Location as "NE/CNW $\frac{1}{4}$ SW $\frac{1}{4}$ " or footage from lines NE SW NW
Lease Owner Petroleum, Inc.
Lease Name Pundsack Well No. 2
Office Address 100 Derby Bldg., Wichita, Kansas
Character of Well (completed as Oil, Gas or Dry Hole) Dry Hole
Date well completed January 10, 1952
Application for plugging filed January 10, 1952
Application for plugging approved January 10, 1952
Plugging commenced January 10, 1952
Plugging completed January 10, 1952
Reason for abandonment of well or producing formation Dry Hole

If a producing well is abandoned, date of last production 19...
Was permission obtained from the Conservation Division or its agents before plugging was commenced? Yes

Name of Conservation Agent who supervised plugging of this well Mr. C. D. Stough
Producing formation Depth to top Bottom Total Depth of Well 3711 Feet
Show depth and thickness of all water, oil and gas formations.

OIL, GAS OR WATER RECORDS

CASING RECORD

Formation	Content	From	To	Size	Put In	Pulled Out
				8 5/8"	333'	None

Describe in detail the manner in which the well was plugged, indicating where the mud fluid was placed and the method or methods used in introducing it into the hole. If cement or other plugs were used, state the character of same and depth placed, from feet to feet for each plug set.

Placed wooden plug at 300' and cemented and displaced 20 sax cement through drill pipe on to plug. Mudded up to 35'. Placed second wooden plug at 35'. Placed 10 sax cement on top of plug filling hole to bottom of cellar

RECEIVED
JAN 22 1952
WICHITA, KANSAS

1-22-52

(If additional description is necessary, use BACK of this sheet)

Correspondence regarding this well should be addressed to Petroleum, Inc.
Address 100 Derby Bldg., Wichita, Kansas

STATE OF KANSAS, COUNTY OF SEDGWICK, ss.
Eric H. Jager (employee of owner) of the above-described well,
being first duly sworn on oath, says: That I have knowledge of the facts, statements, and matters herein contained and the log of the above-described well as filed and that the same are true and correct. So help me God.

(Signature) Eric H. Jager
100 Derby Bldg., Wichita, Kansas (Address)

SUBSCRIBED AND SWORN to before me this 21st day of January, 1952

Charlotte Hedman
Notary Public.

My commission expires October 13, 1954

PLUGGING
FILE SEC 19 T 21 R 13
BOOK PAGE 37 LINE 25

WELL LOG PUNDSACK NO. 2

15.185.11703.0000

Petroleum, Inc., Lease Owner
Garvey Drilling Company, Contractor

Section 19, Twp. 21S, Rge. 13W

Location: NE SW NW

Drilling Commenced: December 29, 1951
Drilling Completed: January 10, 1952

County: Stafford, Kansas

Casing: 8 5/8" @ 333' w/275 sax

Production: D & A

Elevation: 1921 R.B.

Figures below indicate bottom of formation:

50	Surface soil & Sand
165	Sand
200	Sand & Shells
240	Shale
330	Sand
333	Shale
405	Blue Sandy Shale
635	Sand & Shells
825	Red Bed & Shells
850	Anhydrite
1770	Shale & Shells
2370	Lime & Shale
2500	Lime, Shale & Shells
3110	Shale & Lime
3225	Lime
3240	Lime & Shale
3365	Shale & Shells
3505	Lime & Shale
3645	Lime
3675	Lime & Shale
3711	Lime
3711'	R.T.D.

Tops:

Heebner: 3234 (-1313)
 Brown Lime: 3355 (-1434)
 Lansing: 3366 (-1445)
 Arbuckle: 3698 (-1777)

I hereby certify that this is a true and correct log of the above mentioned well.

PETROLEUM, INC.

By Eric H. Jager
Eric H. Jager

STATE OF KANSAS)
COUNTY OF SEDGWICK)

SS: **PLUGGING**
 FILE SEC 19 T21 R13W
 BOOK PAGE 137 LINE 25

Subscribed to and sworn to before me, a Notary Public, in said County and State, this 21st day of January, 1952.

Charlotte Heidman
Notary Public

My commission expires: October 13, 1954