


WELL PLUGGING RECORD

Give All Information Completely
Make Required Affidavit
Mail or Deliver Report to:
Conservation Division
State Corporation Commission
800 Bitting Building
Wichita, Kansas

NORTH

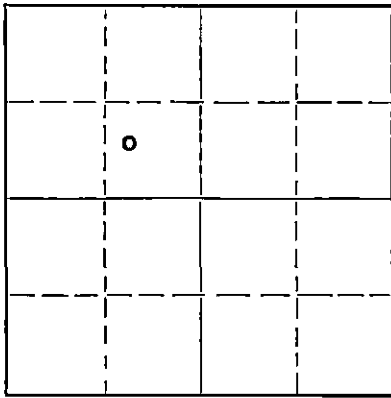

Locate well correctly on above
Section Plat

Stafford County, Sec. 19 Twp. 21 Rge. 13 (E) W(W)
Location as "NE/CNW $\frac{1}{4}$ /SW $\frac{1}{4}$ " or footage from lines C W/2, SE/4, NW/4
Lease Owner Stanolind Oil and Gas Company
Lease Name K. Pundsack "B" Well No. 1
Office Address P. O. Box 1654, Oklahoma City, Oklahoma
Character of Well (completed as Oil, Gas or Dry Hole) Dry Hole
Date well completed 12-17 19 51
Application for plugging filed 1-2 19 52
Application for plugging approved approval to plug by C. D. Stough 19
Plugging commenced 12-22 19 51
Plugging completed 12-30 19 51
Reason for abandonment of well or producing formation formations dry
If a producing well is abandoned, date of last production 19
Was permission obtained from the Conservation Division or its agents before plugging was commenced? Yes

Name of Conservation Agent who supervised plugging of this well C.D. Stough
Producing formation None Depth to top Bottom Total Depth of Well 3764 Feet
Show depth and thickness of all water, oil and gas formations.

OIL, GAS OR WATER RECORDS

CASING RECORD

Formation	Content	From	To	Size	Put In	Pulled Out
Arbuckle	Dry	3691	3764	8-5/8	810	None
Lansing	"	3365	3639	5-1/2	3722	1822

Describe in detail the manner in which the well was plugged, indicating where the mud fluid was placed and the method or methods used in introducing it into the hole. If cement or other plugs were used, state the character of same and depth placed, from feet to feet for each plug set.

Total Depth 3764
Plugged back depth 3448
Dumped 3 sx cement 3448 - 3445
Hvy. Rotary Mud 3445 - 250
15 sx cement 250 - 175
Hvy. Rotary Mud 175 - 50
10 sx cement 50 - to bottom of cellar

JAN - 8 1952 1-3-52

(If additional description is necessary, use BACK of this sheet)
Name of Plugging Contractor Carroll Bros.
Address Ellinwood, Kansas

STATE OF Kansas, COUNTY OF Barton, ss.
G. A. Younie (employee of owner) or (owner or operator) of the above-described well,
being first duly sworn on oath, says: That I have knowledge of the facts, statements, and matters herein contained and the log of the above-described well as filed and that the same are true and correct. So help me God

(Signature) *G. A. Younie*
Box 7, Ellinwood, Kansas
(Address)

SUBSCRIBED AND SWORN to before me this 2nd day of January, 19 52.
Jess S. Nowron
Notary Public.

My commission expires May 2, 1955

23-8390-s 6-51-20M
PLUGGING
FILE SEC 197 & L.R. 130
BOOK PAGE 135 LINE 6

FORMATION RECORD

DESCRIBE EACH FORMATION DRILLED. INDICATE THICKNESS, CONTENT AND WHETHER DRY, OR OIL, GAS, OR WATER BEARING.

FORMATION	TOP	BOTTOM	FORMATION	TOP	BOTTOM
Surface Clay - Sand	0	100			
Sand	100	210			
Shale, shells, sand	210	350			
Shale, shells	350	475			
Red bed, shale	475	809			
Anhydrite	809	1075			
Shale, shells	1075	1775			
Shale, lime	1775	1885			
Lime	1885	2110			
Lime, shale	2110	3060			
Lime	3060	3233			
Hebner Top	3233				
Lime, shale	3233	3275			
Shale	3275	3355			
Icton Top	3355				
Shale, lime	3355	3365			
Lansing Top	3365				
Lime, shale no show	3365	3470			
Lime, no show	3470	3639			
Simson Top	3639				
Lime, no show	3639	3691			
Arbuckle Top	3691				
Dolomite Lime, slight specks of oil	3691	3694			
Ran Schlumberger Elec. Log to TD					
Total Depth:					
By Schlumberger		3694			
By Rotary Drill		3694			
Ran 3727' of 5 1/2" Csg. set @ w/100 sx		3692			
Drilled, sandy dolomite, no shows		TD3764			
Plugged back to no shows		3448			
Well plugged and abandoned	12-30-51				
Total Depth		3764			
Plugged back TD		3448			

PLUGGING
 FILE SEC 197 21 R 13W
 BOOK PAGE 135 LINE 6

