


STATE OF KANSAS
STATE CORPORATION COMMISSION

Form CP-4

Give All Information Completely
Make Required Affidavit
Mail or Deliver Report to:
Conservation Division
State Corporation Commission
212 No. Market
Wichita, Kansas

WELL PLUGGING RECORD

NORTH

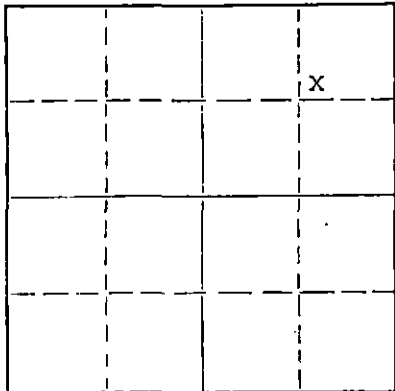

Locate well correctly on above
Section Plat

Rice County, Sec. 3 Twp. 21s Rge. 6 (E) W (W)
Location as "NE/CNW/SW" or footage from lines NE 1/4
Lease Owner Robin Supply Co.
Lease Name Miller Well No. 5
Office Address 1322 E. 50th St., Tulsa, Oklahoma
Character of Well (completed as Oil, Gas or Dry Hole) oil well
Date well completed 7-18-32 19
Application for plugging filed 10-30-69 19
Application for plugging approved 11-4-69 19
Plugging commenced 11-24-69 19
Plugging completed 12-5-69 19
Reason for abandonment of well or producing formation Depleted

If a producing well is abandoned, date of last production 19
Was permission obtained from the Conservation Division or its agents before plugging was commenced? yes

Name of Conservation Agent who supervised plugging of this well Gilbert Toman
Producing formation Depth to top Bottom Total Depth of Well 3398 Feet
Show depth and thickness of all water, oil and gas formations.

OIL, GAS OR WATER RECORDS

CASING RECORD

FORMATION	CONTENT	FROM	TO	SIZE	PUT IN	PULLED OUT
				20"	75'	None
				8 5/8"	3081'	1525.08
				7"	3390'	3253.75

Describe in detail the manner in which the well was plugged, indicating where the mud fluid was placed and the method or methods used in introducing it into the hole. If cement or other plugs were used, state the character of same and depth placed, from feet to feet for each plug set.

Filled bottom from 3398' to 3389' with gravel, mixed and dumped 10 sacks of cement.

Set a 20' rock bridge from 220' to 200', mixed and dumped 15 sacks of cement, left set over night, bailed hole dry, dumped 15 yards of ready mix cement to surface.

RECEIVED
STATE CORPORATION COMMISSION
DEC 18 1969
CONSERVATION DIVISION
Wichita, Kansas

(If additional description is necessary, use BACK of this sheet)
Name of Plugging Contractor Flint Engineering and Construction Co.
Address 2375 W. Central, El Dorado, Kansas

STATE OF Kansas, COUNTY OF Butler, ss.
(employee of owner) or (owner or operator) of the above-described well, being first duly sworn on oath, says: That I have knowledge of the facts, statements, and matters herein contained and the log of the above-described well as filed and that the same are true and correct. So help me God.

(Signature) Richard C. Hausman

(Address) 10th day of December, 1969

James C. Davis

Notary Public.

9-19-71

