


Give All Information Completely
Make Required Affidavit
Mail or Deliver Report to:
Conservation Division
State Corporation Commission
212 North Market, Insurance Bldg.
Wichita, Kansas

WELL PLUGGING RECORD

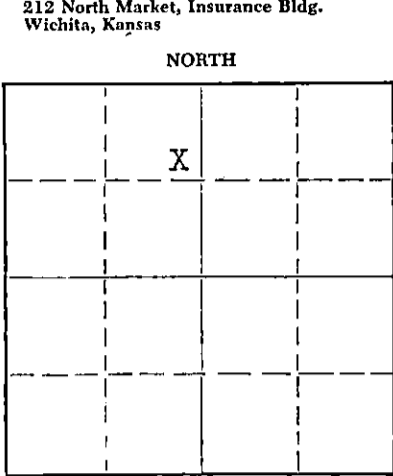

McPherson County, Sec. 31 Twp. 21S Rge. (X) 3(W)
Location as "NE/CNW%SW%" or footage from lines SE NE NW
Lease Owner Brunson-Spines, Inc.
Lease Name Enns Well No. 1
Office Address 302 Union Center, Wichita, Kansas
Character of Well (completed as Oil, Gas or Dry Hole) Dry hole
Date well completed May 14, 1959
Application for plugging filed May 14, 1959
Application for plugging approved May 14, 1959
Plugging commenced May 15, 1959
Plugging completed May 15, 1959
Reason for abandonment of well or producing formation Dry Hole

Locate well correctly on above
Section Plat

If a producing well is abandoned, date of last production _____ 19____
Was permission obtained from the Conservation Division or its agents before plugging was com-
menced? Yes

Name of Conservation Agent who supervised plugging of this well Gilbert Toman
Producing formation _____ Depth to top _____ Bottom _____ Total Depth of Well 3826 Feet
Show depth and thickness of all water, oil and gas formations.

OIL, GAS OR WATER RECORDS

CASING RECORD

FORMATION	CONTENT	FROM	TO	SIZE	PUT IN	PULLED OUT
				8 5/8"	484	None

Describe in detail the manner in which the well was plugged, indicating where the mud fluid was placed and the method or methods used in introducing it into the hole. If cement or other plugs were used, state the character of same and depth placed, from _____ feet to _____ feet for each plug set.

Circulated very heavy mud into hole. Laid down all except 300'
Drill Pipe. Filled hole to 300'. Pushed plug to 300'. Covered with
1/2 sack hulls and 20 sacks cement, mixed and poured through 10 joints
of Drill Pipe. Laid down remainder of Drill Pipe and filled hole to
40'. Pushed plug to 40'. Covered with 1/2 sack hulls and 10 sacks
cement, filling hole to cellar bottom. Plugged rathole with 2 sacks
cement.

RECEIVED
STATE CORPORATION COMMISSION

JUN 2 1959

CONSERVATION DIVISION
Wichita, Kansas

(If additional description is necessary, use BACK of this sheet)

Name of Plugging Contractor Brunson-Spines, Inc.
Address 302 Union Center, Wichita, Kansas

STATE OF Kansas, COUNTY OF Sedgwick, ss.
Ralph B. McLaughlin (employee of owner) or (owner or operator) of the above-described

well, being first duly sworn on oath, says: That I have knowledge of the facts, statements, and matters herein contained and the log of the above-described well as filed and that the same are true and correct. So help me God

(Signature) Ralph B. McLaughlin Secy.-Treas.
302 Union Center, Wichita, Kansas
(Address)

SUBSCRIBED AND SWORN TO before me this 25th day of May, 1959

Mary G. LaFollette
Mary G. LaFollette Notary Public.

My commission expires June 16, 1959

PLUGGING
FILE SEG 31 T 21 R 34
BOOK PAGE 42 LINE 6

BRUNSON-SPINES, INC.
Wichita, Kansas

WELL: ENNS #1

SE NE NW

COMMENCED RD: 4-30-59

31-21S-3W

COMPLETED RD: 5-14-59

TOTAL DEPTH: 3826'

MCPHERSON COUNTY, KANSAS

CASING: 484' 8 5/8"

ELEVATION: 1455 RB

CONTRACTOR: BRUNSON-SPINES, INC.

STRATA	DEPTH	TOPS	
Surface soil & clay	40	Heebner Shale	2319 (-864)
Sand	120	Douglass Sand	2342 (-887)
Clay & Sand	150	Brown Lime	2497 (-1042)
Sand	183	Lansing	2540 (-1085)
Sand & Gravel	213	Base Kansas City	3160 (-1705)
Blue Shale & Shells	450	Mississippi	3274 (-1819)
Anhydrite	660	Steel Line Corr.	3286 (-3294)
Lime & Shale	830	Kinderhook	3541 (-2086)
Lime	1035	Hunton	3691 (-2236)
Lime & Stks. of Shale	1350	Moquoketa	3699 (-2244)
Shale & stks. of Lime	1640	Viola	3811 (-2356)
Lime	1815	Total Depth	3826 (-2371)
Lime & Shale	2232		
Lime	2342		
Sandy Shale	2497		
Shale & Stks. of Lime	2527		
Lime & Shale	2625		
Lime	2747		
Lime & Shale	2862		
Lime	2938		
Lime & Stks. of Shale	3045		
Lime & Shale	3294		
Lime & Chert	3521		
Lime	3575		
Lime & Shale	3775		
Shale	3826		

RECEIVED

STATE OF KANSAS COMMISSION

JUN 2 1959

CONSERVATION DIVISION
Wichita, Kansas

D & A

I hereby certify that the above is a true and correct log of said well as reflected by the daily drilling report.

BRUNSON-SPINES, INC.

Ralph B. McLaughlin
Ralph B. McLaughlin, Secy.-Treas.

Signed and sworn to in my presence this 25th day of May, 1959, by Ralph B. McLaughlin, Secretary-Treasurer of Brunson-Spines, Inc., a Corporation of the State of Kansas.

Mary G. LaFollette
Mary G. LaFollette, Notary Public

My commission expires June 16, 1959.

PLUGGING

FILE - SEC 31.21 R.34
BOOK PAGE 42 LINE 6